

RCSC Middle School **HVAC Replacement**

Project # 2025.0008
January 13, 2026

ADDENDUM NO. A-3

This addendum is issued as a supplement to the plans and specifications and shall be considered an integral part of the same. Acknowledgement of receipt of this addendum is required on the Bid Form.

ARCHITECTURAL

Item: A-3.1

Location: Drawings

Description: Replace sheet G0.0 Cover Sheet dated 1-12-2026 with new drawing dated 1-13-2026. Added an Alternate #7.

Item: A-3.2

Location: Drawings

Description: Replace sheet G1.0 Phasing dated 1-12-2026 with new drawing dated 1-13-2026. Added a scope box with note around AHU-1, purple area.

Item: A-3.3

Location: Drawings

Description: Replace sheet G9.1 Reflected Ceiling Plan Sheet dated 1-12-2026 with new drawing dated 1-13-2026. Added a ceiling grid graphic to Restrooms E118 and E119. Modify existing ceiling to install ceiling recessed unit heaters.

Item: A-3.4

Location: Specifications

Description: Delete Old Bid Form section 004110 and replace with New Bid Form section 004110. Bid sheet adds a line item to state the cost for Alternate #7.

Item: A-3.5

Location: Specifications

Description: Delete old Section 012300 – Alternates and replace with new Section 12300 – Alternates. Added an Alternate #7.

MECHANICAL

Item: M-3.1

Location: Mechanical Drawings: ALL.

Description: Clarification: It is the intent of this project that Temperature Controls Contractor shall furnish the Mechanical Contractor with all new electronic HVAC control valves for the AHU's, VAV's, CUH's, UH's, FTR's, and all other HVAC equipment included within the scope of this project. The Mechanical Contractor shall be responsible for installing the new control valves within the hydronic piping at all HVAC equipment as shown on sheet M5.2. The TCC shall provide and install all low voltage wiring for the new control valves to be connected to the appropriate controller as required for operation.

Item: **M-3.2**
Location: Mechanical Drawings: ALL.
Description: Clarification: It is the intent of this project that Temperature Controls Contractor shall furnish the Electrical Contractor with all new VFD's as required for the AHU's and hydronic pumps equipment included within the scope of this project. The Electrical Contractor shall be responsible for installing the new VFD's on the wall and providing the line voltage connections for the VFD's. The TCC shall provide and install all low voltage wiring and accessories for the new VFD's for a complete and functioning system.

Item: **M-3.3**
Location: Mechanical Drawings: M1.0.
Description: Revision: Revise the Lower Level Mechanical Plan as shown on the attached revised sheet M1.0. Added hydronic piping size tags to the hot water piping that is connected to the VAV's and CUH's. All piping that is connected to the fin tube radiators is to be $\frac{3}{4}$ " \varnothing per the original documents.

Item: **M-3.4**
Location: Mechanical Drawings: M1.1A.
Description: Revision: Revise the First Floor Mechanical Plan – Unit A as shown on the attached revised sheet M1.1A. Added hydronic piping size tags to the hot water piping that is connected to the VAV's and CUH's. All piping that is connected to the fin tube radiators is to be $\frac{3}{4}$ " \varnothing per the original documents.

Item: **M-3.5**
Location: Mechanical Drawings: M1.1A.
Description: Revision: Revise the First Floor Mechanical Plan – Unit A as shown on the attached revised sheet M1.1A. Added a dashed scope box around all ductwork and VAV's associated with air handling unit, AHU-1 to show the extent of work that is to be included in Alternate #5.

Item: **M-3.6**
Location: Mechanical Drawings: M1.1B.
Description: Revision: Revise the First Floor Mechanical Plan – Unit B as shown on the attached revised sheet M1.1B. Added hydronic piping size tags to the hot water piping that is connected to the VAV's and CUH's. All piping that is connected to the fin tube radiators is to be $\frac{3}{4}$ " \varnothing per the original documents.

Item: **M-3.7**
Location: Mechanical Drawings: M1.1C.
Description: Revision: Revise the First Floor Mechanical Plan – Unit C as shown on the attached revised sheet M1.1C. Added hydronic piping size tags to the hot water piping that is connected to the VAV's and CUH's. All piping that is connected to the fin tube radiators is to be $\frac{3}{4}$ " \varnothing per the original documents.

Item: **M-3.8**
Location: Mechanical Drawings: M1.2
Description: Revision: Revise the Penthouse Mechanical Plan as shown on the attached revised sheet M1.2. Added hydronic piping size tags to the chilled water, hot water, and condensate piping that is connected to the air handling units.

Item: **M-3.9**
Location: Mechanical Drawings: M1.2
Description: Revision: Revise the Penthouse Mechanical Plan as shown on the attached revised sheet M1.2. Added a dashed scope box around air handling unit, AHU-1 to show the extent of work that is to be included in Alternate #5.

Item: M-3.10
Location: Mechanical Drawing: M5.3
Description: Revision: It is the intent of this project that Temperature Controls Contractor shall provide the Mechanical Contractor with all new electronic boiler isolation valves for installation within the hydronic piping as shown on the Hot Water Flow Diagram. The Mechanical Contractor shall be responsible for installing the new control valves within the hydronic piping at the boiler as shown on sheet M5.3. The TCC shall provide and install all low voltage wiring for the new control valves to be connected to the appropriate controller as required for operation.

ADDITIONAL CONTRACTOR QUESTIONS AND ANSWERS

Q1: Is a specific document needed for background checks completed on all employees?

A1: Official background checks are to be provided if a contractor is awarded a project. Services such as SafeHiring Solutions can provide the Background Checks needed by the school corporation.

Q2: What documentation is needed to comply with the State of Indiana Common Wage Act? Is this project federally funded?

A2: The School Corporation's Bond is not federally funded. All contractors must comply with all requirements of the Common Wage Act. No documentation is needed, but if the School Corporation is audited, a contractor must provide documentation showing compliance.

Q3: Sheet M1.0 does not indicate any piping sizes. The corresponding flow diagram in detail 1 on sheet M5.3 indicates that most of the piping will be 5 inches. Would it be acceptable to substitute with 6" pipe/fittings in lieu of the 5"?

A3: Bid Piping as shown on the construction documents.

Q4: Please clarify intention for requirements to install VFDs relating to sheet M1.0, note 5 and M1.2, note 3 and sheet E1.2 note 4 and sheet E2.1 note 7?

A4: The TCC shall furnish the VFD and the EC is to physically install and provide line voltage to the units. The TCC will provide the low voltage.

END OF ADDENDUM NO. 3

SECTION 004110 - THE BID FORM

THE PROJECT AND THE PARTIES

1.1 TO:

- A. **Owner**
Rochester Community School Corporation
690 Zebra Lane
Rochester, Indiana 46975

1.2 FOR:

RCSC MS HVAC Replacement

1.3 DATE: _____ (Bidder to enter date)

1.4 SUBMITTED BY: (Bidder to enter name and address)

- A. Bidder's Full Name _____
 Address _____
 City, State, Zip _____

1.5 OFFER (BASE BID)

- A. Having examined the Place of The Work and all matters referred to in the Instructions to Bidders and the Contract Documents prepared by Viridian Architectural Design, Inc. for the above-mentioned project, we, the undersigned, hereby offer to enter into a Contract to perform the Work for the Sum of:
- B. _____
 _____ dollars
 (\$ _____), in lawful money of the United States of America.
- C. Project is Tax Exempt.
- D. All Bonds described in Section 002213 are to be included in the Bid.
- E. All Cash and Contingency Allowances described in Section 012100 **are to be included in the Base Bid Sum.**
- F. All Alternate Lump Sum pricing described in Section 012300 Alternates **are to be included as deductions to the Base Bid,** stated as separate pricing in section 1.8.

1.6 ACCEPTANCE

- A. This offer shall be open to acceptance and is irrevocable for ninety days from the bid closing date.
- B. If this bid is accepted by Owner within the time period stated above, we will:
1. Execute the Agreement within seven days of receipt of Notice of Award.
 2. Furnish the required bonds within seven days of receipt of Notice of Award.
 3. Commence work within seven days after written Notice to Proceed of this bid.

1.7 CONTRACT TIME

- A. If this Bid is accepted, work shall be completed no later than the following:
- B. **Base Bid** – Substantial Completion of the Boiler Room, Penthouse and Classrooms to a state of operational by Friday, July 24, 2026. Substantial Completion of the Project, including Commissioning, by Monday, December 28, 2026.
- C. **Alternates** - Substantial Completion to coincide with the Base Bid Schedule, if possible; or, as determined by negotiation.
- C. Should the Contractor wish to expedite the Contract they may do so by submitting a proposed schedule for review, consideration and comment with their sealed bid.

1.8 OFFER (ALTERNATES)

- A. Having examined the Work and all matters referred to in the Instructions to Bidders and the Contract Documents prepared by Viridian Architectural Design, Inc. for the above-mentioned project, we, the undersigned, hereby offer to include pricing to perform the Work for the Sum of:

ALTERNATE #1 – STATE THE COMPLETE COST TO PROVIDE AND INSTALL LED LIGHTING IN THE BOILER ROOM AND PENTHOUSE.

(\$ _____), in lawful money of the United States of America.

ALTERNATE #2 – STATE THE COMPLETE COST TO PROVIDE AND INSTALL A GAS-POWERED GENERATOR, AS NOTED IN CONSTRUCTION DOCUMENTS.

(\$ _____), in lawful money of the United States of America.

ALTERNATE #3 – STATE THE COMPLETE COST, INCLUDING DEMO OF OLD FIN TUBE HEATER UNITS, TO PROVIDE AND INSTALL CEILING MOUNTED UNIT HEATERS IN THE BOYS AND GIRLS RESTROOMS.

(\$ _____), in lawful money of the United States of America.

ALTERNATE #4—STATE THE COMPLETE COST TO PROVIDE AND INSTALL ALL AIR-HANDLING UNITS, VAV'S AND RELATED EQUIPMENT SHOWN FOR FULL SCOPE OF REPLACEMENT OF AHU-7.

(\$ _____), in lawful money of the United States of America.

ALTERNATE #5—STATE THE COMPLETE COST TO PROVIDE AND INSTALL ALL AIR-HANDLING UNITS, VAV'S AND RELATED EQUIPMENT SHOWN FOR FULL SCOPE OF REPLACEMENT OF AHU-1. THE SCHEDULE WILL BE PHASED BEYOND JULY 24, 2026 UP TO THE DATE OF SUBSTANTIAL COMPLETION.

(\$ _____), in lawful money of the United States of America.

ALTERNATE #6—AFFECTING AHU-1, AHU-2, AND AHU-3: THE TEMPERATURE CONTROL CONTRACTOR SHALL INCLUDE IN THEIR BASE BID REPLACEMENT COST OF THE EXISTING VFD UNITS. THE TEMPERATURE CONTROL CONTRACTOR SHALL STATE THE COMPLETE COST TO DEDUCT THE THREE VFD'S TO REMAIN IN PLACE AND TO BE REUSED. THE CONTRACTOR SHALL INCLUDE IN THIS COST THE VFD IN THE BOILER ROOM THAT WAS REPLACED IN 2021, PER ADDENDUM 02 ITEM M-2.11.

(\$ _____), in lawful money of the United States of America.

ALTERNATE #7—AFFECTING AHU-7, AND NOTED ON SHEET M1.2, CONTRACTOR SHALL STATE THE COMPLETE COST TO DEDUCT THE REPLACEMENT UNIT CHW CONTROL VALVE (REUSING EXISTING CONTROL VALVE).

(\$ _____), in lawful money of the United States of America.

1.9 CHANGES TO THE WORK

- A. When Architect establishes that the method of valuation for Changes in the Work will be net cost plus a percentage fee in accordance with General Conditions, our percentage fee will be:
 - 1. _____ percent overhead and profit on the net cost of our own Work;
 - 2. _____ percent on the cost of work done by any Subcontractor.
- B. On work deleted from the Contract, our credit to Owner shall be Architect-approved net cost plus _____ of the overhead and profit percentage noted above.

1.10 ADDENDA

- A. The following Addenda have been received. The modifications to the Bid Documents noted below have been considered and all costs are included in the Bid Sum.
 - 1. Addendum # _____ Dated _____.
 - 2. Addendum # _____ Dated _____.
 - 3. Addendum # _____ Dated _____.

1.11 BID FORM SIGNATURE(S)

The Corporate Seal of

(Bidder - print the full name of your firm)

was hereunto affixed in the presence of:

(Authorized signing officer, Title)

(Seal)

(Authorized signing officer, Title)

If the Bid is a joint venture or partnership, add additional forms of execution for each member of the joint venture in the appropriate form or forms as above.

END OF SECTION 004110

SECTION 012300 - ALTERNATES

PART 1 - GENERAL

1.1 RELATED DOCUMENTS

- A.** Drawings and general provisions of the Contract, including General and Supplementary Conditions and other Division 1 Specification Sections, apply to this Section.

1.2 SUMMARY

- A.** This Section includes administrative and procedural requirements for alternates.

1.3 DEFINITIONS

- A.** Alternate: An amount proposed by bidders and stated on the Bid Form for certain work defined in the Bidding Requirements that may be deducted from the Base Bid amount if Owner decides to accept a corresponding change either in the amount of construction to be completed or in the products, materials, equipment, systems, or installation methods described in the Contract Documents.

- 1. The credit for each alternate is the net addition to the Contract Sum to incorporate alternates into the Work. No other adjustments are made to the Contract Sum.

1.4 PROCEDURES

- A.** Coordination: Modify or adjust affected adjacent work as necessary to completely integrate work of the alternate into Project.
 - 1. Include as part of each alternate, miscellaneous devices, accessory objects, and similar items incidental to or required for a complete installation whether or not indicated as part of alternate.
- B.** Notification: Immediately following award of the Contract, notify each party involved, in writing, of the status of each alternate. Indicate if alternates have been accepted, rejected, or deferred for later consideration. Include a complete description of negotiated modifications to alternates.
- C.** Execute accepted alternates under the same conditions as other work of the Contract.
- D.** Schedule: A Schedule of Alternates is included at the end of this Section. Specification Sections referenced in schedule contain requirements for materials necessary to achieve the work described under each alternate.

PART 2 - PRODUCTS (NOT USED)

PART 3 - EXECUTION

3.1 SCHEDULE OF ALTERNATES

A. ALTERNATE 1 (DEDUCT)

State the complete cost to remove and replace all room lighting with new LED room lighting for the Boiler Room and Penthouse.

B. ALTERNATE 2 (DEDUCT)

State the cost to provide and install a new gas-powered generator.

C. ALTERNATE 3 (DEDUCT)

State the cost to provide and install Unit Heaters in Boys and Girls Bathrooms, rooms A156 and A159. Clean wall tile thoroughly to match existing. Patch tile with tile of matching appearance, as required, for a like new appearance.

D. ALTERNATE 4 (DEDUCT)

State the cost to provide and install Air Handling units, VAVs and related equipment in Areas Blue, as shown on sheet G1.0 Phasing Plan. See mechanical and electrical drawings for additional information.

E. ALTERNATE 5 (DEDUCT)

State the complete cost to provide and install all air handling units, vav's and related equipment shown for full scope of replacement affecting AHU-1. The schedule for this area will extend beyond July 24, 2026 and will be phased (2) classrooms at a time until complete, up to the substantial completion date.

F. ALTERNATE 6 (DEDUCT)

Affecting AHU-1, AHU-2 and AHU-3: the temperature control contractor shall include in their base bid replacement of the existing VFD units. The temperature control contractor shall state the complete cost to deduct the three VFD's to remain in place and to be reused.

G. ALTERNATE 7 (DEDUCT)

Affecting AHU-7, and noted on sheet M1.2, Contractor shall state the complete cost to deduct the replacement unit CHW control valve (reusing existing control valve).

END OF SECTION 012300

RCSC Middle School

HVAC Replacement

650 Zebra Lane
Rochester, IN

December 22, 2025



6435 West Jefferson Blvd.
#144
Fort Wayne, Indiana 46804
PH: 260.450.7299
www.viridian-design.net

CERTIFICATION



Terry W. Thornsburg

All Concepts, ideas, design elements, plans, and details as shown on this document are the sole property of Viridian Architectural Design, Inc. and shall not be used for any purpose without prior expressed written consent. The Owner shall be permitted to retain copies for information and reference.

ABBREVIATIONS

AB	ANCHOR BOLT	HB	HOSE BIBB	RA	RETURN AIR
AC	AIR CONDITIONING	HDR	HEADER	RAD	RADIUS
ADD	ADDENDUM	HDW	HARDWARE	RB	RUBBER BASE
ADJ	ADJACENT	HWK	HARDWARE	RCB	RESILIENT COVE BASE
AF	ABOVE FINISH FLOOR	HGT	HEIGHT	RCP	REINFORCED CONCRETE PIPE
AFS	ABOVE FINISH SLAB	HM	HOLLOW METAL	RD	ROOF DRAIN
ALT	ALTERNATE	HOR	HORIZONTAL	REF	REFERENCE
ALUM	ALUMINUM	HORIZ	HORIZONTAL	REN	REINFORCING
ANOD	ANODIZED	HP	HEAT PUMP	REV	REVISION (S), REVISED
AP	ACCESS PANEL	HR	HAND RAIL	RG	RETURN REGISTER
APD	AIR PRESSURE DROP	HT	HEIGHT	RH	RIGHT HAND
ARCH	ARCHITECT (URAL)	HTG	HEATING	RM	ROOM
AT	ACOUSTICAL CEILING TILE	HVAC	HEATING/VENTILATING/	RO	ROUGH OPENING
AUTO	AUTOMATIC	HTG	HEATING	RWD	RIGHT OF WAY
AWC	ACRYLIC WALL COATING	HW	HARDWARE	RP	RESIN PANEL
AWP	ACOUSTICAL WALL PANEL	ID	INSIDE DIAMETER	RRD	RELIEF ROOF DRAIN
		INCL	INCLUDE (D), (ING)	RWC	RIGID VINYL WALL COVERING
BD	BOARD	INS	INSULATE (D), (ING)		
BDD	BACKDRAFT DAMPER	INSUL	INSULATION		
BLDG	BUILDING	INT	INTERIOR		
BKGG	BLOCKING	INV	INVERT		
BM	BENCH MARK	IS	INSIDE		
BO	BOTTOM OF...	JC	JANITOR'S CLOSET		
BOM	BOTTOM OF MASONRY	JT	JOINT		
BOB	BOTTOM OF STEEL				
BOT	BOTTOM	KIT	KITCHEN		
BR	BRICK				
		L	LENGTH		
C	CONCRETE	LAV	LAVATORY		
CAB	CABINET	LAM	LAMINATE (D)		
CB	CATCH BASIN	LAT	LEAVING AIR TEMPERATURE		
CFM	CUBIC FEET PER MINUTE	LAV	LAVATORY		
CFT	CUBIC FOOT (C.F.)	LH	LEFT HAND		
CG	CORNER GUARD	LL	LINE LOAD		
CJ	CONTROL JOINT	LT	LIGHT		
CL	CLOSET	LVR	LOUVER		
CLG	CEILING	LVT	LIQUID VINYL TILE		
CLR	CLEAR (ANCE)	LWF	LEAVING WATER TEMPERATURE		
CMU	CONCRETE MASONRY UNIT				
CO	CLEANOUT	M	METER (S)		
COL	COLUMN	MAS	MASONRY		
CONT	CONTINUOUS (CONTINUE)	MAT	MIXED AIR TEMPERATURE, OR WALK-OFF MAT		
CONSTR	CONSTRUCTION	MATL	MATERIALS		
CONTR	CONTRACT (OR)	MB	MOP BASIN		
CP	CHAIR	MDH	1 000 BTU PER HOUR		
CR	CHAIR RAIL	MBM	METAL BUILDING MANUFACTURER		
CT	CERAMIC TILE	MC	MECHANICAL CONTRACTOR		
CYD	CUBIC YARD (C.Y.)	MD	MANUAL DAMPER		
		MECH	MECHANICAL		
DF	DRINKING FOUNTAIN	MFR	MANUFACTURE (ER)		
DIAM	DIAMETER (DIA.)	MFRG	MANUFACTURING		
DWG	DIAGONAL	MH	MANHOLE		
DWM	DIMENSION	MIN	MINIMUM		
DIV	DIVISION	MISC	MISCELLANEOUS		
DL	DOOR	ML	MILLIMETER (S)		
DS	DOWNSPOUT	MO	MASONRY OPENING		
DTL	DETAIL	MOD	MOTOR OPERATED DAMPER		
DWG	DRAWING	MT	MOUNT (ED), (ING)		
		MTL	METAL		
E	EAST	MTLS	METALS		
EA	EACH				
EAL	EXHAUST AIR LOUVER	N	NORTH		
EAT	ENTERING AIR TEMPERATURE	NIC	NOT IN CONTRACT		
EC	ELECTRICAL CONTRACTOR	NOM	NOMINAL		
EF	EACH FACE, OR EXHAUST FAN	NRC	NOISE REDUCTION COEFFICIENT		
EG	EXHAUST GRILLE	NTS	NOT TO SCALE		
EJ	EXPANSION JOINT				
EL	ELEVATION	OA	OUTSIDE AIR		
ELEC	ELECTRIC (AL)	OAL	OUTSIDE AIR LOUVER		
ELEV	ELEVATOR	OCC	ON CENTER (S)		
EMER	EMERGENCY	OD	OUTSIDE DIAMETER		
EPT	EPOXY PAINT	OH	OVERHEAD		
EQ	EQUAL	OJ	OPEN WEB JOIST		
EQUIP	EQUIPMENT	OPG	OPENING		
ESP	EXTERNAL STATIC PRESSURE	OPH	OPPOSITE HAND		
EWC	ELECTRIC WATER COOLER	OPP	OPPOSITE		
EWT	ENTERING WATER TEMPERATURE	P	PAINT (ED)		
EXH	EXHAUST	PCB	PORCELAIN COVE BASE		
EXIST	EXISTING	PCF	POUNDS PER CUBIC FOOT		
EXP	EXPOSED	PERF	PERFORATE (S)		
EXT	EXTERIOR	PF	FOUR FLOORING		
		PKG	PARKING		
F.C.	FORWARD CURVED FAN	PLF	POUNDS PER LINEAL FOOT		
FA	FIRE ALARM	PL	PROPERTY LINE		
FAV	FIELD APPLIED VINYL	PLAM	PLASTIC LAMINATE		
FD	FIRE DAMPER	PNL	PANEL		
FD	FLOOR DRAIN	PNT	POINT		
FDC	FIRE DEPARTMENT CONNECTION	PP	PORCELAIN (PAVERS)		
FDN	FOUNDATION	PSF	POUNDS PER SQUARE FOOT		
FE	FIRE EXTINGUISHER	PSI	POUNDS PER SQUARE INCH		
FEC	FIRE EXTINGUISHER CABINET	PT	PORCELAIN TILE		
FF	FINISH FLOOR	PFL	PRESSURE TREATED		
FFE	FINISH FLOOR ELEVATION	PVC	POLYVINYL CHLORIDE		
PFL	FINISHED FLOOR LINE	PVMT	PAVEMENT		
FIN	FINISH	PWD	PLYWOOD		
FLR	FLOOR (ING)	QT	QUARRY TILE		
FFC	FIRE PROTECTION CONTRACTOR				
FFY	FINIS PER FOOT				
FTG	FOOTING				
GA	GAGE, GAUGE				
GALV	GALVANIZED				
GC	GENERAL CONTRACT (OR)				
GL	GLASS				
GPM	GALLONS PER MINUTE				
GWB	GYPSONUM WALL BOARD				
GYP	GYPSONUM				

LIST OF WORKING DRAWINGS

GO.0	COVER SHEET	01	M2.1	FIRST FLOOR MECHANICAL PLAN ALTERNATES - UNITS A#B	22
G1.0	PHASING PLAN	02	M5.1	MECHANICAL DETAILS	23
G1.1	LIFE SAFETY PLAN	03	M5.2	MECHANICAL DETAILS	24
			M5.3	MECHANICAL DETAILS	25
A1.1	FIRST FLOOR PLAN - ALTERNATE 3	04	M5.4	MECHANICAL DETAILS	26
A2.1	ARCHITECTURAL ROOF PLAN AND DETAILS	05	M6.1	MECHANICAL SCHEDULES	27
A9.1	FIRST FLOOR REFLECTED CEILING PLAN	06			
			ED1.1	ELECTRICAL DEMOLITION PLAN - UNIT A	28
MG1.0	MECHANICAL GENERAL NOTES	07	ED1.2	ELECTRICAL DEMOLITION PLAN - UNIT B	29
MD1.0	DEMOLITION - LOWER LEVEL MECHANICAL PLAN	08	ED1.3	ELECTRICAL DEMOLITION PLAN - UNIT C	30
MD1.1A	DEMOLITION - FIRST FLOOR MECHANICAL PLAN - UNIT A	09	ED2.1	ELECTRICAL DEMOLITION PLAN - PENTHOUSE	31
MD1.1B	DEMOLITION - FIRST FLOOR MECHANICAL PLAN - UNIT B	10	ED2.2	ELECTRICAL DEMOLITION PLAN - ROOF	32
MD1.1C	DEMOLITION - FIRST FLOOR MECHANICAL PLAN - UNIT C	11	E1.1	NEW ELECTRICAL PLAN - UNIT A	33
MD1.2	DEMOLITION - PENTHOUSE MECHANICAL PLAN	12	E1.2	NEW ELECTRICAL PLAN - UNIT B	34
MD1.3A	DEMOLITION - ROOF MECHANICAL PLAN - UNIT A	13	E1.3	NEW ELECTRICAL PLAN - UNIT C	35
MD1.3B	DEMOLITION - ROOF MECHANICAL PLAN - UNIT B	14	E2.1	NEW ELECTRICAL PLAN - PENTHOUSE	36
M1.0	LOWER LEVEL MECHANICAL PLAN	15	E2.2	NEW ELECTRICAL PLAN - ROOF	37
M1.1A	FIRST FLOOR MECHANICAL PLAN - UNIT A	16	E3.0	ELECTRICAL SCHEDULE AND DETAILS	38
M1.1B	FIRST FLOOR MECHANICAL PLAN - UNIT B	17			
M1.1C	FIRST FLOOR MECHANICAL PLAN - UNIT C	18			
M1.2	PENTHOUSE MECHANICAL PLAN	19			
M1.3A	ROOF MECHANICAL PLAN - UNIT A	20			
M1.3B	ROOF MECHANICAL PLAN - UNIT B	21			

ALTERNATES

GENERAL: ALL ALTERNATES ARE DEDUCTIVE FROM THE BASE BID, IF ACCEPTED.

ALTERNATE-1: STATE THE COMPLETE COST TO PROVIDE AND INSTALL LED LIGHTING IN THE BOILER ROOM AND PENTHOUSE, AS NOTED IN CONSTRUCTION DOCUMENTS.

ALTERNATE-2: STATE THE COMPLETE COST TO PROVIDE AND INSTALL A GAS-POWERED GENERATOR, AS NOTED IN CONSTRUCTION DOCUMENTS.

ALTERNATE-3: STATE THE COMPLETE COST, INCLUDING DEMO OF OLD FIN TUBE HEATER UNITS, TO PROVIDE AND INSTALL CEILING MOUNTED UNIT HEATERS IN THE BOYS AND GIRLS RESTROOMS.


ALTERNATE-4: STATE THE COMPLETE COST TO PROVIDE AND INSTALL ALL AIR HANDLING UNITS, VAVS AND RELATED EQUIPMENT SHOWN FOR FULL SCOPE OF REPLACEMENT AFFECTING AHU-1.

ALTERNATE-5: STATE THE COMPLETE COST TO PROVIDE AND INSTALL ALL AIR HANDLING UNITS, VAVS AND RELATED EQUIPMENT SHOWN FOR FULL SCOPE OF REPLACEMENT AFFECTING AHU-1. THE SCHEDULE FOR THIS AREA WILL EXTEND BEYOND JULY 24, 2026 AND WILL BE PHASED (2) CLASSROOMS AT A TIME UNTIL COMPLETE, UP TO THE SUBSTANTIAL COMPLETION DATE.

ALTERNATE-6: AFFECTING AHU-1, AHU-2 AND AHU-3 THE TEMPERATURE CONTROL CONTRACTOR SHALL INCLUDE IN THEIR BASE BID REPLACEMENT OF THE EXISTING VFD UNITS. THE TEMPERATURE CONTROLS CONTRACTOR SHALL STATE THE COMPLETE COST TO DEDUCT THE THREE VFD'S TO REMAIN IN PLACE AND TO BE REUSED. THE CONTRACTOR SHALL INCLUDE IN THIS COST THE VFD IN THE BOILER ROOM THAT WAS REPLACED IN 2021, PER ADDENDUM 02 ITEM M-2.1.1.

ALTERNATE-7: AFFECTING AHU-7, AND NOTED ON SHEET M1.2, CONTRACTOR SHALL STATE THE COMPLETE COST TO DEDUCT THE REPLACEMENT UNIT CHW CONTROL VALVE (REUSING EXISTING CONTROL VALVE).

GRAPHIC SYMBOLS LEGEND

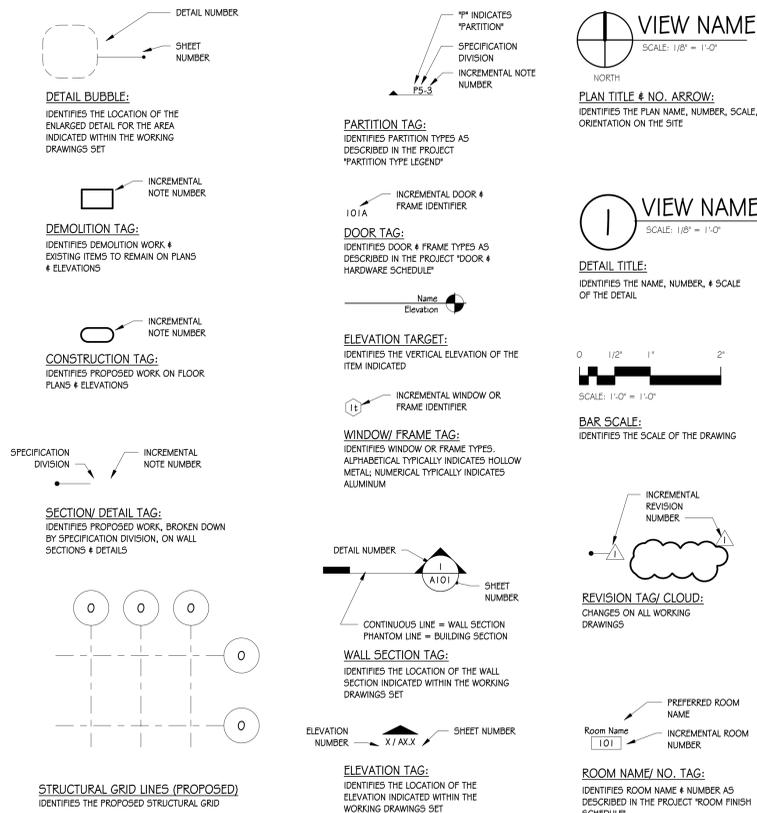

DESIGN & CONSTRUCTION TEAM

ARCHITECT / INTERIOR DESIGN / ELECTRICAL ENGINEER:

VIRIDIAN ARCHITECTURAL DESIGN INC.
6435 WEST JEFFERSON BLVD. #144
FORT WAYNE, INDIANA 46804
P: 260-450-7299
WWW.VIRIDIAN-DESIGN.NET



MECHANICAL ENGINEER:

SCO ENGINEERING, LLC
6554 CONSTITUTION DRIVE
FORT WAYNE, INDIANA 46805
P: 260-438-9213
SCOENR@SCO-LLC.COM



ELECTRICAL ENGINEER:

C-H ENGINEERING, INC.
13313 DOLCETTO CV
FORT WAYNE, INDIANA 46845
P: 260-450-0501
CHEENGINEERING@FRONTIER.COM



PROJECT LOCATION

650 ZEBRA LANE
ROCHESTER, IN



PROJECT LOCATION

SCALE: NOT TO SCALE

REVISION	DATE	DESCRIPTION
1	01-12-2026	ADDENDUM 002
2	1-13-2026	ADDENDUM 003

DATE	PROJECT
12/22/25	20250008
	TITLE
	COVER SHEET

SHEET
GO.0

RCSC Middle School
HVAC Replacement
650 Zebra Lane
Rochester, IN

CERTIFICATION



Terry W. Thornsbury

All Concepts, ideas, design elements, plans, and details as shown on this document are the sole property of Viridian Architectural Design, Inc. and shall not be used for any purpose without prior expressed written consent. The Owner shall be permitted to retain copies for information and reference.

RCSC Middle School
HVAC Replacement
650 Zebra Lane
Rochester, IN


REVISION	DATE	DESCRIPTION
1	01-12-2026	ADDENDUM 002
2	1-13-2026	ADDENDUM 003

DATE	PROJECT
12/22/25	20250008

TITLE
PHASING PLAN


SHEET

G1.0

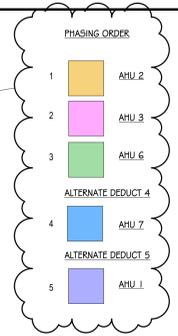


- GENERAL NOTES:**
- THE OWNER EXPECTS THE CONTRACTOR TO CREATE A SCHEDULE OF WORK TO COMPLETE ALL WORK FOR THE PROJECT DURING THE SCHOOLS SUMMER BREAK (TO THE GREATEST EXTENT FEASIBLE); EVEN MAKING USE OF DOUBLE SHIFTS, AS NEEDED. IF THE REALISTIC SCHEDULE DOES NOT PERMIT THIS WORK TO BE COMPLETED OVER THE SUMMER, THE PRIORITY ORDER OF PHASING FOR REPLACEMENT OF VAVS AND OTHER EQUIPMENT (DISRUPTING CLASSROOM AREAS) SHALL FOLLOW THE ORDER OF THE ADJACENT COLORED LEGEND, FROM TOP TO BOTTOM.
 - COORDINATE WITH THE OWNER ON TEMPORARY RELOCATION OF CLASSROOMS TO ALLOW WORK IN VACANT CLASSROOMS. PROTECT ALL EXISTING SCHOOL FURNITURE AND EQUIPMENT TO REMAIN IN THE ROOM. THE CONTRACTOR CAN SCHEDULE WORK FOR TWO CLASSROOMS AT A TIME UNTIL COMPLETE.
 - THE CONTRACTOR SHALL PROVIDE SUFFICIENT MAN POWER TO COMPLETE WORK IN A TIMELY MANNER.
 - WORK IN THE PENTHOUSE AND BOILER ROOM SHALL OCCUR PARALLEL AND TANDEM TO EACH OTHER AS WORK PERMITS AND AS MAN POWER ALLOWS; AVOID THE USE OF LINEAR SEQUENCE, SINGLE FOCUS TASKS, AND ENDEAVOR TO PROCEED WITH WORK IN AN EFFICIENT MANNER.
 - MECHANICAL AHUS SERVING THE BUILDING WILL MAINTAIN THEIR EXISTING ZONING, AS WELL AS THEIR RESPECTIVE INDIVIDUAL ROOMS AFFECTED BY TEMPERATURE CONTROL DEVICES. SEE MECHANICAL AND ELECTRICAL DRAWINGS FOR ADDITIONAL INFORMATION.


NOTE:
CONTRACTOR TO PROTECT ALL INTERIOR AND EXTERIOR BUILDING COMPONENTS AND FINISHES THROUGHOUT THE DURATION OF CONSTRUCTION. THIS INCLUDES, BUT IS NOT LIMITED TO, WALLS, FLOORS, DOORS, ROOF, SIDEWALKS, ASPHALT, GREEN SPACES, LANDSCAPING, ETC. CONTRACTOR SHALL BE RESPONSIBLE FOR REPAIR OF ALL DAMAGED SURFACES AND ITEMS PRIOR TO COMPLETION OF CONSTRUCTION.

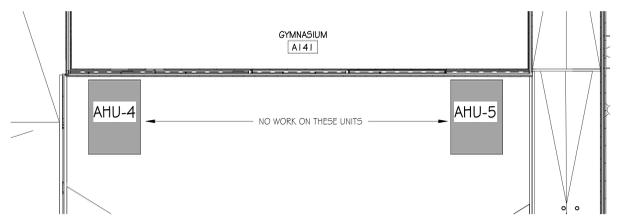


4 ROOF PLAN BY GYM - UNIT B
SCALE: 1/16" = 1'-0"

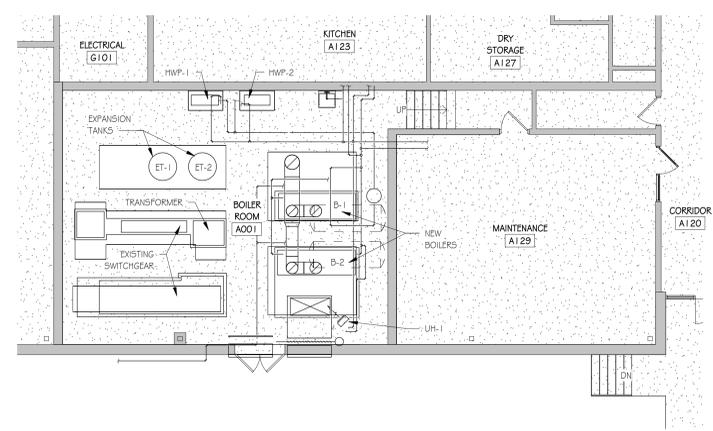


3 BOILER ROOM PLAN
SCALE: 1/8" = 1'-0"

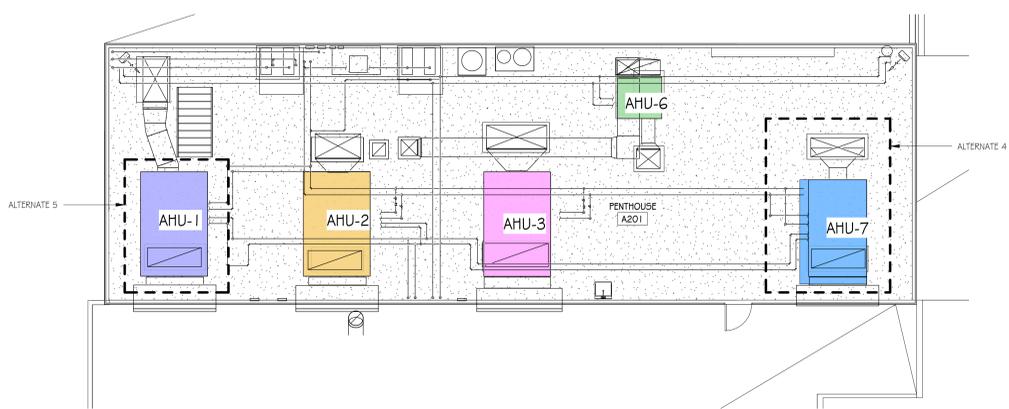

2 PENTHOUSE PLAN
SCALE: 1/8" = 1'-0"

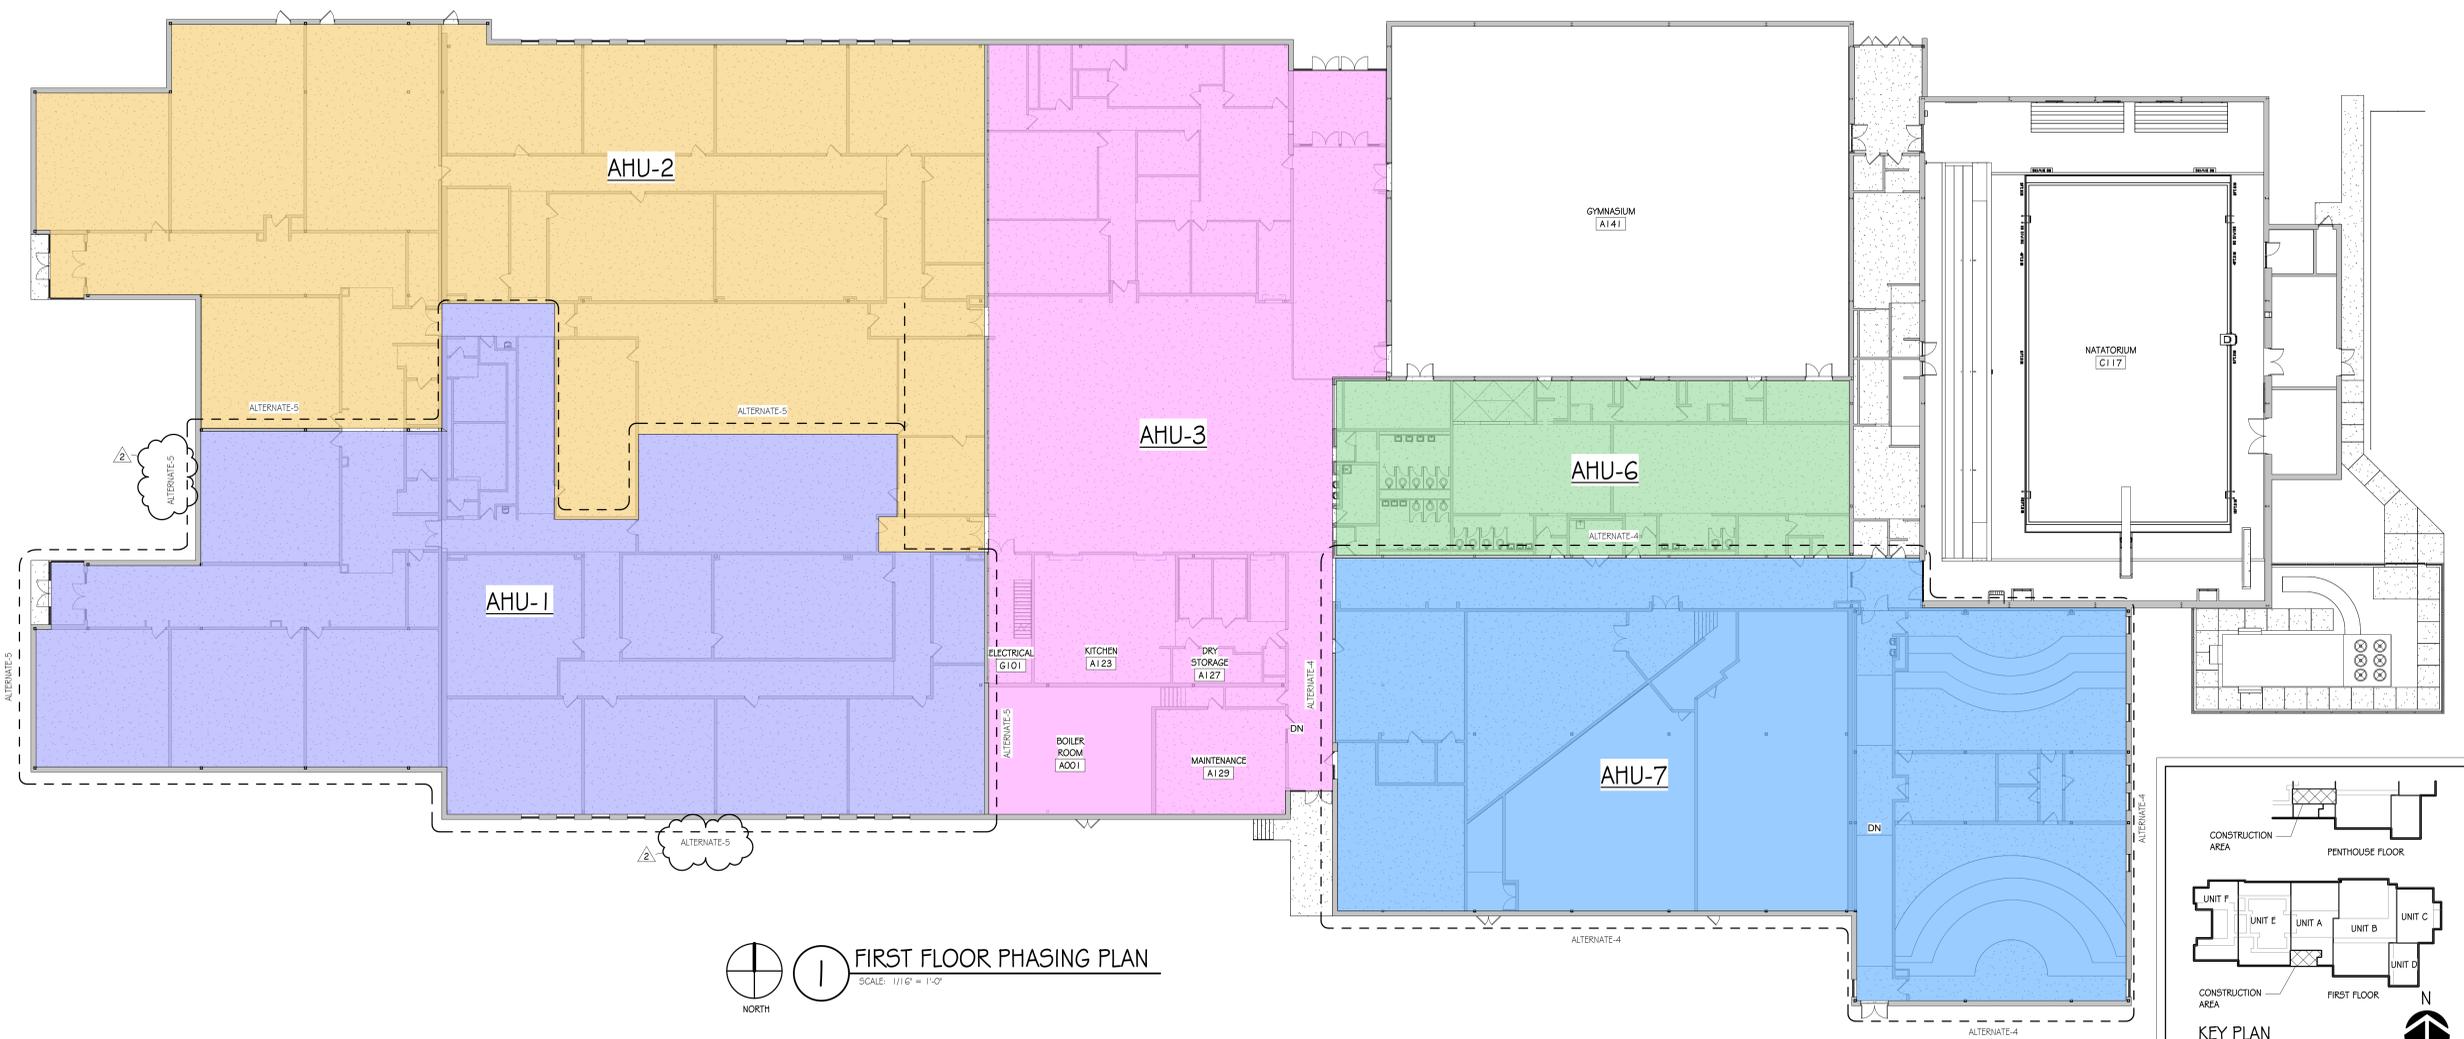

1 FIRST FLOOR PHASING PLAN
SCALE: 1/16" = 1'-0"

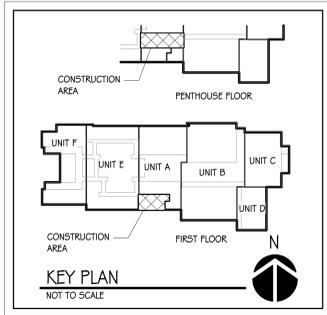

one and one half inches = one foot
one inch = one foot
three quarters inch = one foot
one half inch = one foot
three eighths inch = one foot
one quarter inch = one foot
one eighth inch = one foot

CERTIFICATION



All Concepts, ideas, design elements, plans, and details as shown on this document are the sole property of Viridian Architectural Design, Inc. and shall not be used for any purpose without prior expressed written consent. The Owner shall be permitted to retain copies for information and reference.



FORT WAYNE
6534 Constitution Drive
Fort Wayne, IN 46804
(260) 436-9213
(260) 432-5481 fax
scow@sc-engineering.com

This is an original design, created by SCO ENGINEERING, LLC. The concepts, ideas, plans and details are the sole property of SCO ENGINEERING, LLC. None of the concepts, ideas, plans or details shall be used or disclosed to any person, firm or corporation for any purpose without the prior written permission of SCO ENGINEERING, LLC. Written dimensions on these drawings shall have precedence over scale dimensions. Contractors shall verify and be responsible for all dimensions and conditions on the job and SCO ENGINEERING, LLC must be notified of any variation from the dimensions and conditions shown on these drawings. Shop drawings shall be submitted to SCO ENGINEERING, LLC for approval before fabrication.
Copyright 2025 ©

RCSC Middle School
HVAC Replacement
690 Zebra Lane
Rochester, IN

REVISION	DATE	DESCRIPTION
1	01-12-26	Addendum 03

DATE	PROJECT
12/22/25	20250008

TITLE
LOWER LEVEL MECHANICAL PLAN

SHEET



MI.0

MECHANICAL PLAN NOTES


- 1. ALL SCOPE OF WORK WITHIN THIS SERIES OF DRAWINGS, ARE THE RESPONSIBILITY OF THE MECHANICAL CONTRACTOR. MECHANICAL CONTRACTOR SHALL COORDINATE ALL WORK WITHIN THIS SCOPE OF WORK WITH ALL OTHER TRADES AND GENERAL CONTRACTOR/CONSTRUCTION MANAGER.
- 2. CONTRACTOR SHALL PROVIDE AND INSTALL NEW FAN POWERED VAV BOX IN THE SAME LOCATION AS THE PREVIOUSLY REMOVED BOX. CONTRACTOR SHALL PROVIDE AND INSTALL ALL REQUIRED COMPONENTS, WIRING, DUCTWORK, CONTROLS, AND ACCESSORIES REQUIRED FOR A COMPLETE AND FUNCTIONING SYSTEM. TIE-IN AND CONNECT TO EXISTING HOT WATER SUPPLY AND HOT WATER RETURN PIPING. MECHANICAL CONTRACTOR SHALL MODIFY AND EXTEND THE EXISTING SHEETMETAL DUCTWORK AS REQUIRED TO INSTALL THE NEW VAV BOX. PROVIDE AN ADDITIONAL 5'-0" LINEAR FOOT OF DUCTWORK AND RE-CONNECT TO THE EXISTING DUCTWORK AND EXTEND THE DUCTWORK AS REQUIRED FOR THE INSTALLATION OF THE VAV IN THE LOCATION AS SHOWN. PROVIDE AND INSTALL ALL NECESSARY OFFSETS AND TRANSITIONS IN DUCTWORK AS REQUIRED. ROUTE HYDRONIC PIPING TO UNIT PER 2-WAY OR 3-WAY PIPING DETAIL ON SHEET MS-1. REFER TO SERIES FAN POWERED VARIABLE AIR VOLUME BOX SCHEDULE FOR VALVE REQUIREMENT.
- 3. PROVIDE AND INSTALL NEW DOC TEMPERATURE SENSOR/THERMOSTAT TO BE INSTALLED WITHIN THE SAME LOCATION AS THE PREVIOUSLY REMOVED THERMOSTAT. THE NEW SENSOR SHALL BE INSTALLED WITHIN THE EXISTING WALL BOX AND THE NEW CONTROL WIRING SHALL BE ROUTED DOWN THE WALL WITHIN THE EXISTING CONDUIT FOR CONNECTION TO THE NEW SENSOR. TEMPERATURE CONTROLS CONTRACTOR SHALL PROVIDE AND INSTALL ALL CONTROL WIRING, RELAYS, AND ACCESSORIES AS REQUIRED FOR A COMPLETE AND FUNCTIONING SYSTEM. CONTRACTOR SHALL BE RESPONSIBLE TO PROVIDE AND INSTALL ALL ELECTRICAL COMPONENTS/WIRING AS REQUIRED TO CONNECT THE SYSTEM FOR A FULLY FUNCTIONING SYSTEM. WIRING SHALL BE INSTALLED PER THE CURRENT INDIANA NEC CODE.
- 4. PROVIDE AND INSTALL NEW HYDRONIC HOT WATER PUMPS ON EXISTING HOUSEKEEPING PAD IN THE SAME LOCATION AS THE PREVIOUSLY REMOVED PUMPS. CONTRACTOR SHALL BE RESPONSIBLE TO ENLARGE HOUSEKEEPING PAD AS REQUIRED FOR INSTALLATION. REFER TO HOT WATER FLOW DIAGRAM SHEET MS-3 FOR PIPING LAYOUT, ADDITIONAL REQUIREMENTS, AND ADDITIONAL INFORMATION FOR PIPING AND MECHANICAL UNITS WITHIN THIS AREA.
- 5. PROVIDE AND INSTALL A NEW SIDE STREAM FILTER AND AUTOMATIC CHEMICAL FEEDER WITH 2 VALVE BYPASS AND DRAIN TO BE INSTALLED IN THE HYDRONIC HOT WATER CLOSED LOOP SYSTEM. FILTER FEEDER IS TO BE A NEPTUNE FFF-50B WITH CORROSION COUPON RACK IN THE RECIRCULATING LINES. THE CONNECTION TO THE FILTER FEEDER SHALL BE OFF THE MAIN SUPPLY AND RETURN HEADER SO THAT THERE IS A CONSTANT FLOW THROUGH THE FILTER FEEDER REGARDLESS OF WHICH PUMP IS RUNNING. REFER TO THE HOT WATER FLOW DIAGRAM ON SHEET MS-3. CONTRACTOR SHALL BE RESPONSIBLE TO ENLARGE HOUSEKEEPING PAD AS REQUIRED FOR INSTALLATION.
- 6. TEMPERATURE CONTROLS CONTRACTOR SHALL PROVIDE AND INSTALL NEW VARIABLE SPEED DRIVES FOR BASE-LOADED PUMPS COMPLETE FOR A FULLY FUNCTIONING SYSTEM. COORDINATE INSTALLATION LOCATION WITH MANUFACTURER'S CLEARANCES AND PROVIDE AND INSTALL VFD ON METAL UNI-STRUT STAND SEPARATE FROM UNIT.
- 7. PROVIDE AND INSTALL NEW CONDENSING BOILER ON EXISTING HOUSEKEEPING PAD INCLUDING ALL PIPING, CONTROLS, WIRING, COMBUSTION AIR & FLUE PIPING, AND ALL ACCESSORIES FOR A COMPLETE AND FUNCTIONING SYSTEM. CONTRACTOR SHALL CLEAN AND SURGE ALL EXISTING HYDRONIC WATER PIPING PRIOR TO INSTALLATION OF NEW BOILERS TO INSURE THAT THE EXISTING HYDRONIC WATER PIPING IS FREE OF ANY CONTAMINANTS. TIE-IN AND CONNECT NEW GAS PIPING FROM THE EXISTING GAS MAIN AND ROUTE FOR CONNECTION TO THE BOILER. PROVIDE AND INSTALL NEW GAS PRESSURE REGULATOR AND GAS COOK VALVE, AND PIPE UNION AT CONNECTION TO UNIT. BOILERS ARE TO BE PROVIDED WITH CARBON MONOXIDE SENSORS AND EMERGENCY BOILER SHUT OFF VALVES WITH PUSH BUTTONS. REFER TO ELECTRICAL DRAWINGS FOR ADDITIONAL INFORMATION AND INSTALLATION REQUIREMENTS FOR PUSH BUTTONS. PROVIDE ALL WORKING CLEARANCES PER MANUFACTURER'S INSTALLATION REQUIREMENTS. REFER TO THE HOT WATER FLOW DIAGRAM ON SHEET MS-3 FOR ADDITIONAL PIPING REQUIREMENTS AND INFORMATION.
- 8. ROUTE 10" PVC COMBUSTION AIR AND 10" AL29-4C FLUE DUCT FROM BOILERS AND ROUTE AS SHOWN. ROUTE COMBUSTION AIR AND FLUE PIPE UP THROUGH ROOF AS SHOWN AND TERMINATE WITH MANUFACTURER RECOMMENDED TERMINATION CAP. PROVIDE ALL REQUIRED SPOOL PIECES REQUIRED FOR ROUTING UP THROUGH THE ROOF. REUSE AND MOODY DRYING ROOF OPENING FOR COMBUSTION AIR PIPING. MAINTAIN ALL REQUIRED CLEARANCES FROM OUTDOOR INTAKES PER THE INTERNATIONAL MECHANICAL CODE.
- 9. PROVIDE AND INSTALL HOT WATER EXPANSION TANKS ON EXISTING HOUSEKEEPING PAD. REFER TO HOT WATER FLOW DIAGRAM FOR PIPING REQUIREMENTS AND ADDITIONAL INFORMATION.
- 10. PROVIDE AND INSTALL NEW CEILING HUNG UNIT HEATER TO BE INSTALLED IN THE SAME LOCATION AS THE PREVIOUSLY REMOVED UNIT. TIE-IN AND CONNECT TO EXISTING HOT WATER SUPPLY AND HOT WATER RETURN PIPING. ROUTE HYDRONIC PIPING TO UNIT PER 2-WAY OR 3-WAY PIPING DETAIL ON SHEET MS-1.
- 11. TIE-IN AND CONNECT NEW HYDRONIC HOT WATER SUPPLY AND HOT WATER RETURN PIPING TO THE EXISTING HYDRONIC WATER PIPING IN LOCATION AS SHOWN. PROVIDE AND INSTALL ALL OFFSETS AND TRANSITIONS IN PIPING AS REQUIRED FOR CONNECTION.
- 12. PROVIDE AND INSTALL A NEW MODULATING DAMPER AND ELECTRONIC DAMPER ACTUATOR TO THE EXISTING OUTSIDE AIR DUCTWORK THAT IS TO REMAIN. PROVIDE AND INSTALL NEW DOC CONTROLS, INCLUDING ALL CONTROL WIRING, RELAYS, AND ACCESSORIES AS REQUIRED FOR A COMPLETE AND FUNCTIONING SYSTEM. CONTRACTOR SHALL BE RESPONSIBLE TO PROVIDE AND INSTALL ALL ELECTRICAL COMPONENTS/WIRING AND PROGRAMMING AS REQUIRED TO CONNECT THE SYSTEM FOR A FULLY FUNCTIONING SYSTEM. WIRING SHALL BE INSTALLED PER THE CURRENT INDIANA NEC CODE.
- 13. TIE-IN AND CONNECT NEW DOMESTIC COLD WATER PIPING TO THE EXISTING COLD WATER PIPING IN LOCATION AS SHOWN. PROVIDE AND INSTALL ALL VALVES, OFFSETS, AND FITTINGS IN PIPING AS REQUIRED FOR CONNECTION FOR UNRESTRICTED FLOW WITHIN THE SYSTEM.
- 14. TIE-IN AND CONNECT NEW 2-1/2" SCHEDULE 40 STEEL GAS PIPING TO EXISTING EXTERIOR GAS PIPE HEADER LOCATED ON THE SOUTH SIDE OF BUILDING AND ROUTE FOR CONNECTION TO NEW NATURAL GAS GENERATOR. PROVIDE AND INSTALL GAS COOK SHUT OFF VALVE AND A SERVICE TYPE REGULATOR TO REDUCE THE INCOMING GAS PRESSURE TO LOW-C. GAS PRESSURE AND SURFACE MOUNT THE GAS PIPING TO THE BUILDING AND ROUTE FOR CONNECTION TO THE NEW GENERATOR. EXTERIOR PIPING SHALL BE SURFACE MOUNTED WITH STAINLESS STEEL STAND-OFFS AND HANGERS. CONTRACTOR SHALL CLEAN, PRIME, AND PAINT ALL EXPOSED EXTERIOR NATURAL GAS PIPING AND HANGERS WITH RUST INHIBITING PAINT. ARCHITECT TO SELECT COLOR. COORDINATE PIPING ROUTING WITH EXISTING BUILDING STRUCTURE, EXISTING UTILITIES, AND ALL TRADES PRIOR TO THE INITIATION OF ANY WORK.
- 15. CONTRACTOR SHALL COORDINATE WITH GAS UTILITIES TO PROVIDE NEW NATURAL GAS METER AS REQUIRED BASED ON THE ADDITIONAL NATURAL GAS REQUIREMENTS FOR THE NEW EQUIPMENT TO BE ADDED TO THE EXISTING SYSTEM AS PART OF THIS PROJECT. IF THE EXISTING METER IS TO BE UPGRADED, INSTALL NEW GAS METER AND CONNECTING PIPING. COORDINATE WORK WITH GAS UTILITY FOR SHUTDOWN AND TO PROVIDE A NEW METER AND SERVICE REGULATOR AS REQUIRED FOR NEW CALCULATED EQUIPMENT LOAD. TOTAL CALCULATED ADDITIONAL CONNECTED LOAD OF NEW EQUIPMENT FOR THE RENOVATIONS IS 446 CFH. INCLUDE ALL ASSOCIATED COSTS TO REPLACE CURRENT PRESSURE REGULATORS AND METER AS REQUIRED FOR NEW GAS LOAD REQUIREMENTS AND INCLUDE ALL ASSOCIATED FEES FROM GAS UTILITIES IN BID. GAS UTILITIES TO PROVIDE PRESSURE REDUCING VALVE, METER, AND CONNECT TO EXISTING NATURAL GAS SERVICE.

IT IS THE INTENT OF THIS PROJECT THAT THE MECHANICAL CONTRACTOR SHALL REMOVE THE EXISTING CEILING GRID AND CEILING TILES AS REQUIRED FOR THE REMOVAL AND REINSTALLATION OF NEW WORK. ONCE ALL THE WORK IS COMPLETE, THE CONTRACTOR SHALL REINSTALL THE PREVIOUSLY REMOVED CEILING GRID AND TILES TO MATCH THE SURROUNDING AREAS. IF ANY OF THE GRID OR TILES IS DAMAGED DURING CONSTRUCTION, IT IS THE RESPONSIBILITY OF THE MECHANICAL CONTRACTOR TO PROVIDE AND INSTALL NEW GRID/TILES. REFER TO ARCHITECTURAL PLANS FOR ADDITIONAL INFORMATION AND REQUIREMENTS.

IT IS THE INTENT OF THIS PROJECT THAT ALL NEW HVAC EQUIPMENT SHALL BE PROVIDED WITH NEW DOC CONTROLS COMPLETE, INCLUDING ALL NEW ELECTRONIC DAMPER ACTUATORS, ELECTRONIC HOT WATER/CHILLED WATER CONTROL VALVES, NEW FREEZE STAT, SENSORS, CONTROL WIRING, RELAYS, AND ACCESSORIES REQUIRED FOR A COMPLETE AND FUNCTIONING SYSTEM. CONTRACTOR SHALL BE RESPONSIBLE TO PROVIDE AND INSTALL ALL ELECTRICAL POWER, COMPONENTS/WIRING AND PROGRAMMING AS REQUIRED TO CONNECT THE SYSTEM FOR A FULLY FUNCTIONING SYSTEM. WIRING SHALL BE INSTALLED PER THE CURRENT INDIANA NEC CODE.

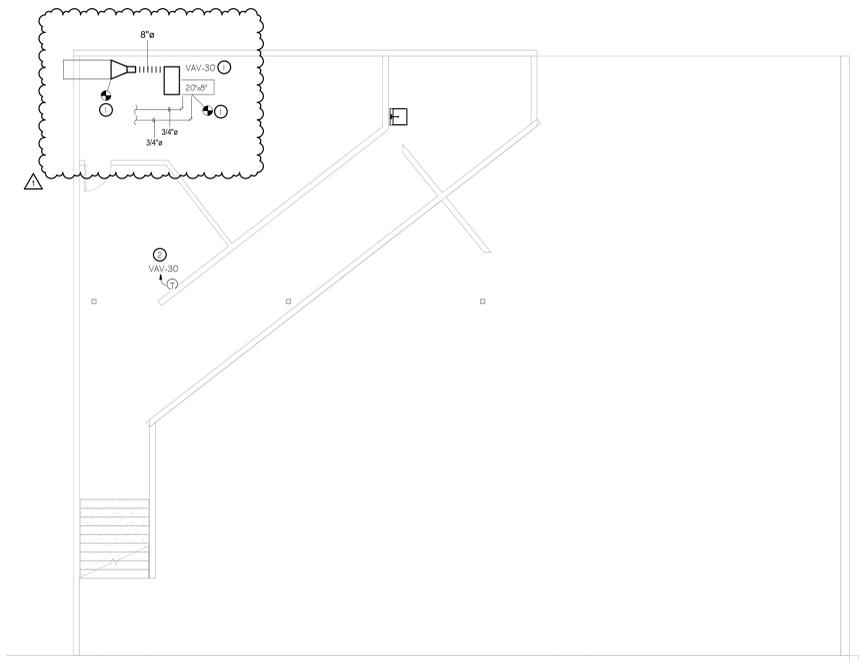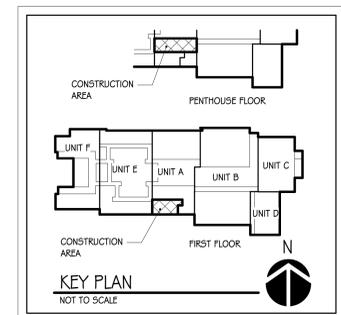

2 LOWER LEVEL MECHANICAL PLAN
SCALE: 1/8" = 1'-0"
NORTH

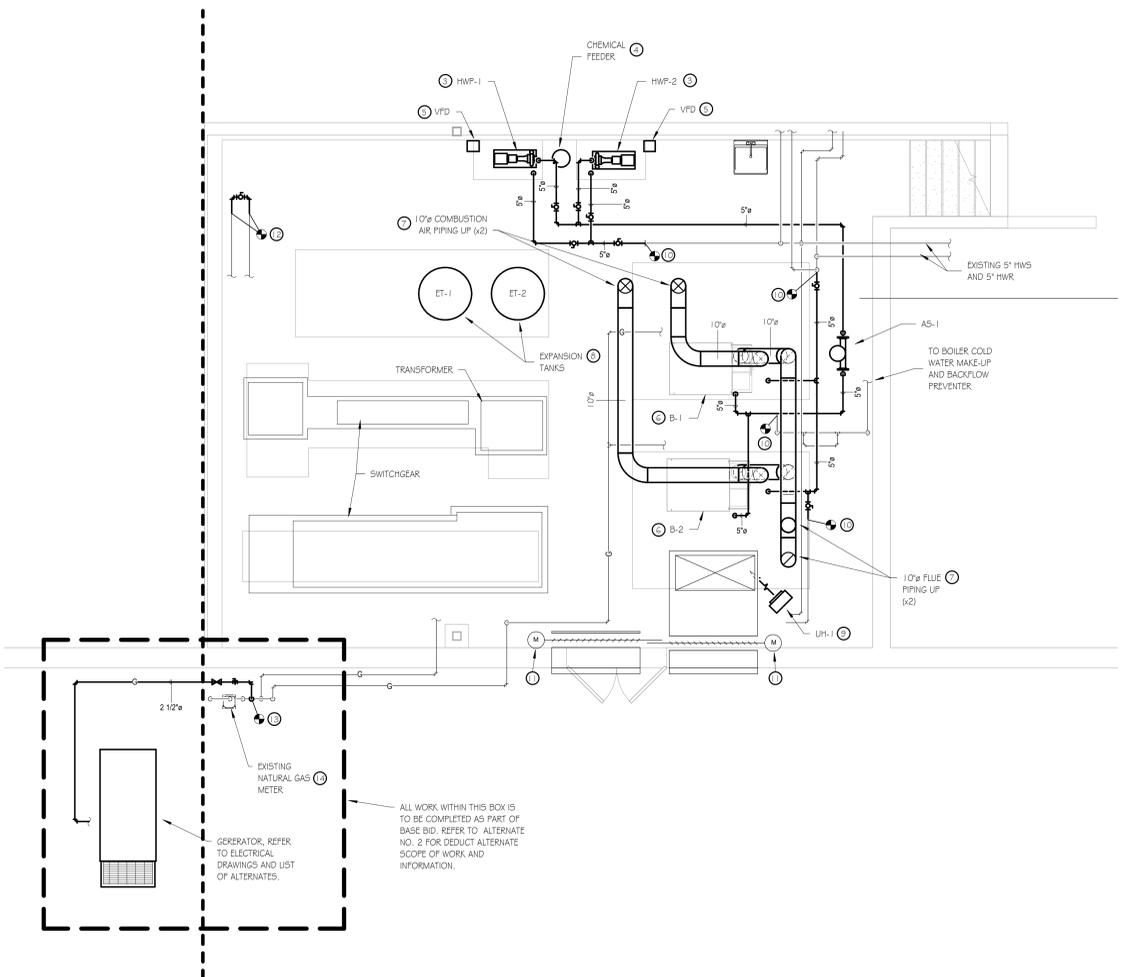

1 LOWER LEVEL MECHANICAL BOILER ROOM PLAN
SCALE: 1/4" = 1'-0"
NORTH

one and one half inches = one foot
one inch = one foot
one inch = one foot
three quarters inch = one foot
one half inch = one foot
one half inch = one foot
three eighths inch = one foot
one quarter inch = one foot
one eighth inch = one foot
one eighth inch = one foot

CERTIFICATION



All Concepts, ideas, design elements, plans, and details as shown on this document are the sole property of Viridian Architectural Design, Inc. and shall not be used for any purpose without prior expressed written consent. The Owner shall be permitted to retain copies for information and reference.



FORT WAYNE
6534 Convallaria Drive
Fort Wayne, IN 46804
(260) 436-9213
(260) 432-5481 fax
scoll@sc-engineering.com

This is an original design, created by SCO ENGINEERING, LLC. The concepts, ideas, plans and details are the sole property of SCO ENGINEERING, LLC. None of the concepts, ideas, plans or details shall be used or disclosed to any person, firm or corporation for any purpose without the prior written permission of SCO ENGINEERING, LLC. Written dimensions on these drawings shall have precedence over scale dimensions. Contractors shall verify and be responsible for all dimensions and conditions on the job and SCO ENGINEERING, LLC must be notified of any variation from the dimensions and conditions shown on these drawings. Shop drawings shall be submitted to SCO ENGINEERING, LLC for approval before fabrication.
Copyright 2025 ©

RCSC Middle School
HVAC Replacement
690 Zebra Lane
Rochester, IN

REVISION	DATE	DESCRIPTION
1	01-12-26	Addendum 03

DATE	PROJECT
12/22/25	20250008

TITLE
FIRST FLOOR MECHANICAL PLAN - UNIT A

SHEET


MI.1A

MECHANICAL PLAN NOTES

- ALL SCOPE OF WORK WITHIN THIS SERIES OF DRAWINGS, ARE THE RESPONSIBILITY OF THE MECHANICAL CONTRACTOR. MECHANICAL CONTRACTOR SHALL COORDINATE ALL WORK WITHIN THIS SCOPE OF WORK WITH ALL OTHER TRADES AND GENERAL CONTRACTOR/CONSTRUCTION MANAGER.
- CONTRACTOR SHALL PROVIDE AND INSTALL NEW FAN POWERED VAV BOX IN THE SAME LOCATION AS THE PREVIOUSLY REMOVED BOX. PROVIDE AND INSTALL A PERMANENTLY AFFIXED EQUIPMENT LABEL TO THE CEILING GRID TO IDENTIFY THE LOCATION OF THE UNIT. COORDINATE INSTALLATION LOCATION OF THE LABEL WITH THE OWNER PRIOR TO INSTALLATION. CONTRACTOR SHALL PROVIDE AND INSTALL ALL REQUIRED COMPONENTS, WIRING, DUCTWORK, CONTROLS, AND ACCESSORIES REQUIRED FOR A COMPLETE AND FUNCTIONING SYSTEM. TIE-IN AND CONNECT TO EXISTING HOT WATER SUPPLY AND HOT WATER RETURN PIPING. MECHANICAL CONTRACTOR SHALL MODIFY AND EXTEND THE EXISTING SHEETMETAL DUCTWORK AS REQUIRED TO INSTALL THE NEW VAV BOX. PROVIDE AN ADDITIONAL 5'-0" LINEAR FOOT OF DUCTWORK AND RE-CONNECT TO THE EXISTING DUCTWORK AND EXTEND THE DUCTWORK AS REQUIRED FOR THE INSTALLATION OF THE VAV IN THE LOCATION AS SHOWN. PROVIDE AND INSTALL ALL NECESSARY OFFSETS AND TRANSITIONS IN DUCTWORK AS REQUIRED. ROUTE HYDRONIC PIPING TO UNIT PER 2-WAY OR 3-WAY PIPING DETAIL ON SHEET MS. 1. REFER TO SERIES FAN POWERED VARIABLE AIR VOLUME BOX SCHEDULE FOR VALVE REQUIREMENT.
- PROVIDE AND INSTALL NEW DDC TEMPERATURE SENSOR/THERMOSTAT TO BE INSTALLED WITHIN THE SAME LOCATION AS THE PREVIOUSLY REMOVED THERMOSTAT. THE NEW SENSOR SHALL BE INSTALLED WITHIN THE EXISTING WALL BOX AND THE NEW CONTROL WIRING SHALL BE ROUTED DOWN THE WALL WITHIN THE EXISTING CONDUIT FOR CONNECTION TO THE NEW SENSOR. TEMPERATURE CONTROLS CONTRACTOR SHALL PROVIDE AND INSTALL ALL CONTROL WIRING, RELAYS, AND ACCESSORIES AS REQUIRED FOR A COMPLETE AND FUNCTIONING SYSTEM. CONTRACTOR SHALL BE RESPONSIBLE TO PROVIDE AND INSTALL ALL ELECTRICAL COMPONENTS/WIRING AS REQUIRED TO CONNECT THE SYSTEM FOR A FULLY FUNCTIONING SYSTEM. WIRING SHALL BE INSTALLED PER THE CURRENT INDIANA NEC CODE.
- CONTRACTOR SHALL PROVIDE AND INSTALL NEW CABINET UNIT HEATER IN THE SAME LOCATION AS THE PREVIOUSLY REMOVED HEATER. TIE-IN AND CONNECT NEW HYDRONIC HOT WATER SUPPLY AND RETURN PIPING TO THE EXISTING PIPING WITHIN THE WALL AND MAKE CONNECTIONS TO THE HEATER. PROVIDE AND INSTALL ALL NEW VALVES, COMPONENTS, ACCESSORIES AND NEW TEMPERATURE CONTROL VALVES FOR A COMPLETE AND FUNCTIONING SYSTEM. MECHANICAL CONTRACTOR TO PROVIDE AND INSTALL ALL NECESSARY OFFSETS AND TRANSITIONS IN PIPING AS REQUIRED FOR CONNECTION TO UNIT. MECHANICAL CONTRACTOR SHALL BE RESPONSIBLE TO CUT AND NOTCH EXISTING WALL AS REQUIRED FOR INSTALLATION OF HEATER AND ALL COMPONENTS. CONTRACTOR SHALL PATCH THE EXISTING WALL AS REQUIRED TO MATCH THE SURROUNDING CONDITIONS AND PROVIDE A FULLY SEALED WALL CONDITION. REFER TO UNIT HEATER # CABINET UNIT HEATER 2-WAY VALVE CONTROL PIPING DETAIL FOR ADDITIONAL INFORMATION.
- CONTRACTOR SHALL PROVIDE AND INSTALL NEW FIN TUBE RADIATOR IN THE SAME LOCATION AS THE PREVIOUSLY REMOVED HEATER. TIE-IN AND CONNECT NEW HYDRONIC HOT WATER SUPPLY AND RETURN PIPING TO THE EXISTING PIPING WITHIN THE WALL AND MAKE CONNECTIONS TO THE HEATER. PROVIDE AND INSTALL ALL NEW VALVES, COMPONENTS, ACCESSORIES AND NEW TEMPERATURE CONTROL VALVES FOR A COMPLETE AND FUNCTIONING SYSTEM. MECHANICAL CONTRACTOR TO PROVIDE AND INSTALL ALL NECESSARY OFFSETS AND TRANSITIONS IN PIPING AS REQUIRED FOR CONNECTION TO UNIT. CONTRACTOR SHALL FIELD MEASURE AND VERIFY THE EXACT LENGTH OF FIN TUBE AND ENCLOSURE THAT IS REQUIRED TO BE INSTALLED IN THE LOCATION SHOWN. MECHANICAL CONTRACTOR SHALL BE RESPONSIBLE TO CUT AND NOTCH EXISTING WALL AS REQUIRED FOR INSTALLATION OF HEATER AND ALL COMPONENTS. CONTRACTOR SHALL PATCH THE EXISTING WALL AS REQUIRED TO MATCH THE SURROUNDING CONDITIONS AND PROVIDE A FULLY SEALED WALL CONDITION. REFER TO UNIT HEATER # CABINET UNIT HEATER 2-WAY VALVE CONTROL PIPING DETAIL FOR ADDITIONAL INFORMATION.
- PROVIDE AND INSTALL NEW DDC CONTROLS, INCLUDING ALL NEW ELECTRONIC DAMPER ACTUATORS, ELECTRONIC HOT WATER/CHILLED WATER CONTROL VALVES, NEW FREEZE STAT, SENSORS, CONTROL WIRING, RELAYS, AND ACCESSORIES TO THE NEW AIR HANDLING UNIT THAT IS REQUIRED FOR A COMPLETE AND FUNCTIONING SYSTEM. CONTRACTOR SHALL BE RESPONSIBLE TO PROVIDE AND INSTALL ALL ELECTRICAL POWER, COMPONENTS/WIRING AND PROGRAMMING AS REQUIRED TO CONNECT THE SYSTEM FOR A FULLY FUNCTIONING SYSTEM. WIRING SHALL BE INSTALLED PER THE CURRENT INDIANA NEC CODE.
- CONTRACTOR SHALL PROVIDE AND INSTALL NEW CEILING HUNG CABINET UNIT HEATER IN THE SUSPENDED ACoustical CEILING GRID IN LOCATION SHOWN. CONTRACTOR SHALL VERIFY FINAL INSTALLATION LOCATION OF THE NEW HEATER WITH THE EXISTING LIGHTING FIXTURES THAT ARE TO REMAIN. HEATER IS TO BE INSTALLED IN A LOCATION THAT DOES NOT REQUIRE THE LIGHTS TO BE RELOCATED. MOUNT AND TIE-IN NEW HYDRONIC HOT WATER SUPPLY AND RETURN PIPING TO THE EXISTING PIPING ABOVE THE CEILING AND MAKE CONNECTIONS TO THE HEATER. ALL EXISTING PIPING WITHIN THE WALL THAT WAS PREVIOUSLY CONNECTED TO THE REMOVED FIN TUBE IS TO BE CAPPED AND DISASSEMBLED IN PLACE. PROVIDE AND INSTALL ALL NEW VALVES, COMPONENTS, ACCESSORIES AND NEW TEMPERATURE CONTROL VALVES FOR A COMPLETE AND FUNCTIONING SYSTEM. MECHANICAL CONTRACTOR TO PROVIDE AND INSTALL ALL NECESSARY OFFSETS AND TRANSITIONS IN PIPING AS REQUIRED FOR CONNECTION TO UNIT. MECHANICAL CONTRACTOR SHALL BE RESPONSIBLE TO CUT AND NOTCH THE EXISTING WALL AS WITH FULL CMU BLOCK AS REQUIRED TO MATCH THE SURROUNDING CONDITIONS AND PROVIDE A FULLY SEALED WALL CONDITION. REFER TO UNIT HEATER # CABINET UNIT HEATER 2-WAY VALVE CONTROL PIPING DETAIL FOR ADDITIONAL INFORMATION.

IT IS THE INTENT OF THIS PROJECT THAT THE MECHANICAL CONTRACTOR SHALL REMOVE THE EXISTING CEILING GRID AND CEILING TILES AS REQUIRED FOR THE REMOVAL AND REINSTALLATION OF NEW WORK. ONCE ALL THE WORK IS COMPLETE, THE CONTRACTOR SHALL REINSTALL THE PREVIOUSLY REMOVED CEILING GRID AND TILES TO MATCH THE SURROUNDING AREAS. IF ANY OF THE GRID OR TILES IS DAMAGED DURING CONSTRUCTION, IT IS THE RESPONSIBILITY OF THE MECHANICAL CONTRACTOR TO PROVIDE AND INSTALL NEW GRIDDLES. REFER TO ARCHITECTURAL PLANS FOR ADDITIONAL INFORMATION AND REQUIREMENTS.

IT IS THE INTENT OF THIS PROJECT THAT ALL NEW HVAC EQUIPMENT SHALL BE PROVIDED WITH NEW DDC CONTROLS COMPLETE, INCLUDING ALL NEW ELECTRONIC DAMPER ACTUATORS, ELECTRONIC HOT WATER/CHILLED WATER CONTROL VALVES, NEW FREEZE STAT, SENSORS, CONTROL WIRING, RELAYS, AND ACCESSORIES REQUIRED FOR A COMPLETE AND FUNCTIONING SYSTEM. CONTRACTOR SHALL BE RESPONSIBLE TO PROVIDE AND INSTALL ALL ELECTRICAL POWER, COMPONENTS/WIRING AND PROGRAMMING AS REQUIRED TO CONNECT THE SYSTEM FOR A FULLY FUNCTIONING SYSTEM. WIRING SHALL BE INSTALLED PER THE CURRENT INDIANA NEC CODE.

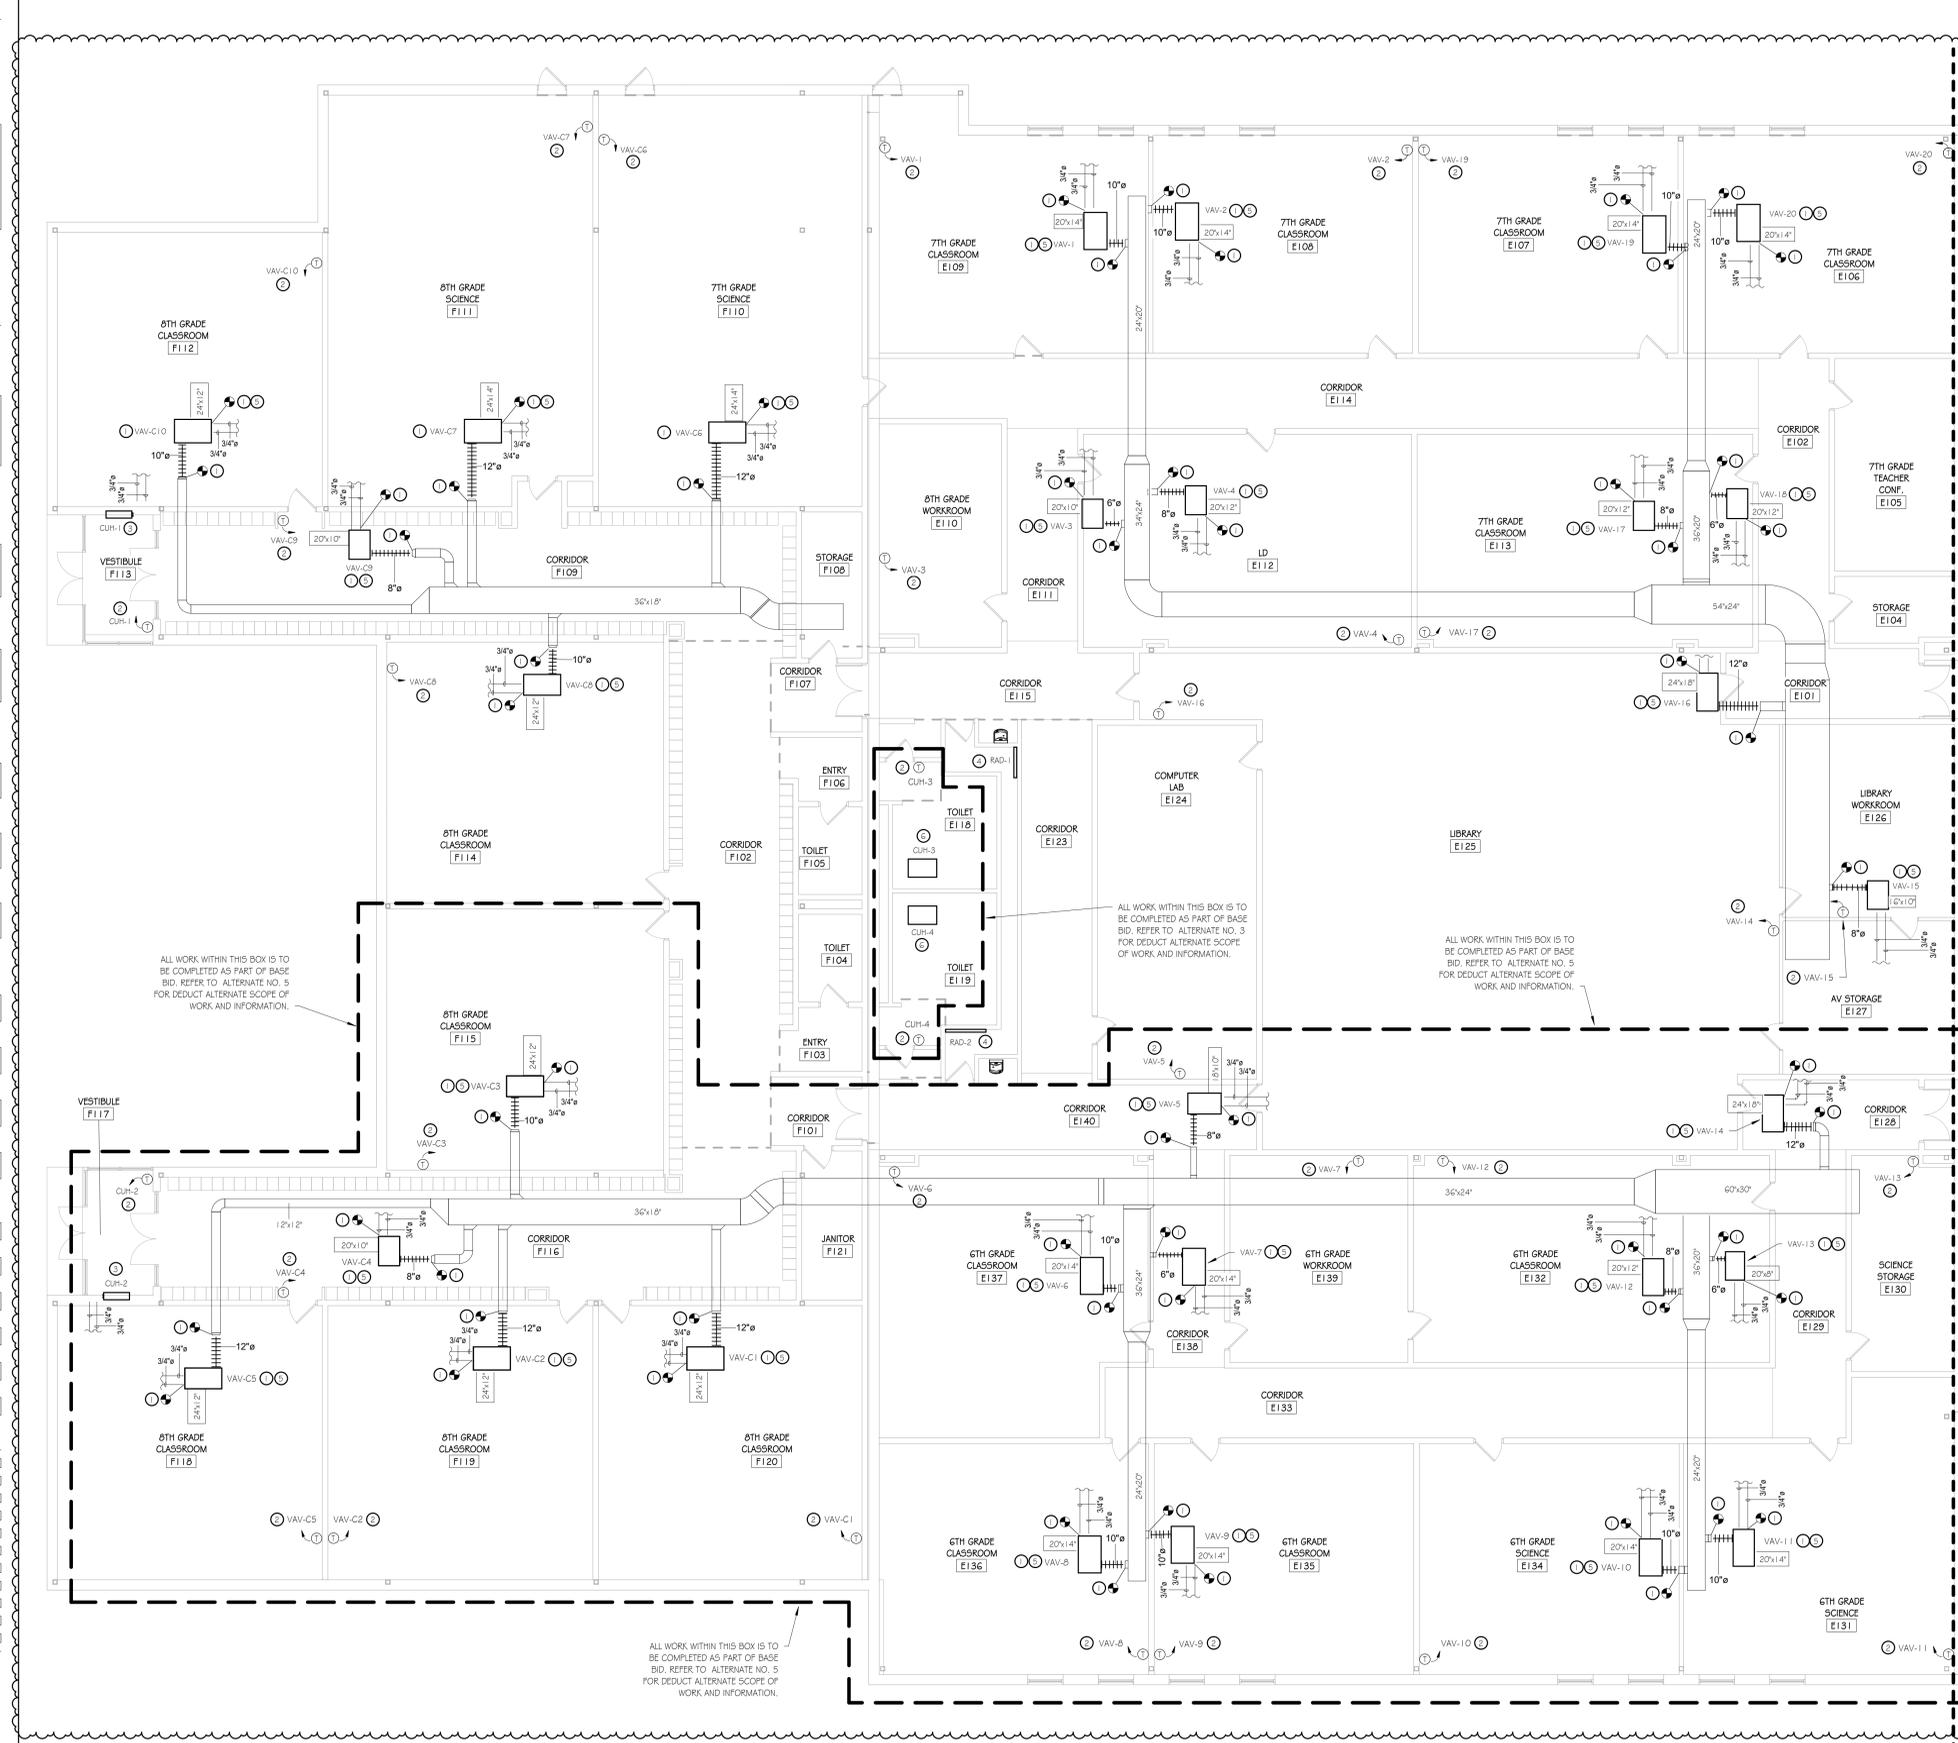


one and one half inches = one foot
one inch = one foot
three quarters inch = one foot
one half inch = one foot
three eighths inch = one foot
one quarter inch = one foot
one eighth inch = one foot

ALL WORK WITHIN THIS BOX IS TO BE COMPLETED AS PART OF BASE BID. REFER TO ALTERNATE NO. 5 FOR DEDUCT ALTERNATE SCOPE OF WORK AND INFORMATION.

ALL WORK WITHIN THIS BOX IS TO BE COMPLETED AS PART OF BASE BID. REFER TO ALTERNATE NO. 5 FOR DEDUCT ALTERNATE SCOPE OF WORK AND INFORMATION.

ALL WORK WITHIN THIS BOX IS TO BE COMPLETED AS PART OF BASE BID. REFER TO ALTERNATE NO. 5 FOR DEDUCT ALTERNATE SCOPE OF WORK AND INFORMATION.

FIRST FLOOR MECHANICAL PLAN - UNIT A
SCALE: 1/8" = 1'-0"
NORTH

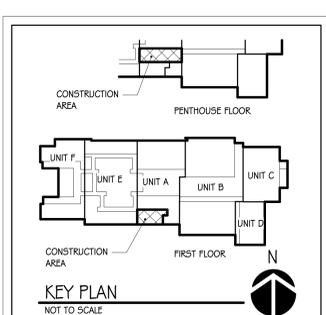

CERTIFICATION



All Concepts, ideas, design elements, plans, and details as shown on this document are the sole property of Viridian Architectural Design, Inc. and shall not be used for any purpose without prior expressed written consent. The Owner shall be permitted to retain copies for information and reference.



FORT WAYNE
6534 Convallaria Drive
Fort Wayne, IN 46804

(260) 436-9213
(260) 432-5481 fax
scoll@scoc-llc.com

This is an original design, created by SCO ENGINEERING, LLC. The concepts, ideas, plans and details are the sole property of SCO ENGINEERING, LLC. None of the concepts, ideas, plans or details shall be used or disclosed to any person, firm or corporation for any purpose without the prior written permission of SCO ENGINEERING, LLC. Written dimensions on these drawings shall have precedence over scale dimensions. Contractors shall verify and be responsible for all dimensions and conditions on the job and SCO ENGINEERING, LLC must be notified of any variation from the dimensions and conditions shown on these drawings. Shop drawings shall be submitted to SCO ENGINEERING, LLC for approval before fabrication.
Copyright 2025 ©

RCSC Middle School
HVAC Replacement
690 Zebra Lane
Rochester, IN

REVISION	DATE	DESCRIPTION
1	01-12-26	Addendum 02
2	01-12-26	Addendum 03

DATE **12/22/25** PROJECT **20250008**

TITLE **FIRST FLOOR MECHANICAL PLAN - UNIT B**

SHEET


MI.1B

MECHANICAL PLAN NOTES


- 1. ALL SCOPE OF WORK WITHIN SERIES OF DRAWINGS, ARE THE RESPONSIBILITY OF THE MECHANICAL CONTRACTOR. MECHANICAL CONTRACTOR SHALL COORDINATE ALL WORK WITHIN THIS SCOPE OF WORK WITH ALL OTHER TRADES AND GENERAL CONTRACTOR/CONSTRUCTION MANAGER.
- 2. CONTRACTOR SHALL PROVIDE AND INSTALL NEW FAN POWERED VAV BOX IN THE SAME LOCATION AS THE PREVIOUSLY REMOVED BOX. PROVIDE AND INSTALL A PERMANENTLY AFFIXED EQUIPMENT LABEL TO THE CEILING GRID TO IDENTIFY THE LOCATION OF THE UNIT. COORDINATE INSTALLATION LOCATION OF THE LABEL WITH THE OWNER PRIOR TO INSTALLATION. CONTRACTOR SHALL PROVIDE AND INSTALL ALL REQUIRED COMPONENTS, WIRING, DUCTWORK, CONTROLS, AND ACCESSORIES REQUIRED FOR A COMPLETE AND FUNCTIONING SYSTEM. TE-IN AND CONNECT TO EXISTING HOT WATER SUPPLY AND HOT WATER RETURN PIPING. MECHANICAL CONTRACTOR SHALL MODIFY AND EXTEND THE EXISTING SHEETMETAL DUCTWORK AS REQUIRED TO INSTALL THE NEW VAV BOX. PROVIDE AN ADDITIONAL 5'-0" LINEAR FOOT OF DUCTWORK AND RE-CONNECT TO THE EXISTING DUCTWORK AND EXTEND THE DUCTWORK AS REQUIRED FOR THE INSTALLATION OF THE VAV IN THE LOCATION AS SHOWN. PROVIDE AND INSTALL ALL NECESSARY OFFSETS AND TRANSITIONS IN DUCTWORK AS REQUIRED. ROUTE HYDRONIC PIPING TO UNIT PER 2-WAY OR 3-WAY PIPING DETAIL ON SHEET MS-1. REFER TO SERIES FAN POWERED VARIABLE AIR VOLUME BOX SCHEDULE FOR VALVE REQUIREMENT.
- 3. PROVIDE AND INSTALL NEW DDC TEMPERATURE SENSOR/THERMOSTAT TO BE INSTALLED WITHIN THE SAME LOCATION AS THE PREVIOUSLY REMOVED THERMOSTAT. THE NEW SENSOR SHALL BE INSTALLED WITHIN THE EXISTING VAV BOX AND THE NEW CONTROL WIRING SHALL BE ROUTED DOWN THE WALL WITHIN THE EXISTING CONDUIT FOR CONNECTION TO THE NEW SENSOR. TEMPERATURE CONTROL CONTRACTOR SHALL PROVIDE AND INSTALL ALL CONTROL WIRING, RELAYS, AND ACCESSORIES AS REQUIRED FOR A COMPLETE AND FUNCTIONING SYSTEM. CONTRACTOR SHALL BE RESPONSIBLE TO PROVIDE AND INSTALL ALL ELECTRICAL COMPONENTS AS REQUIRED TO CONNECT THE SYSTEM FOR A FULLY FUNCTIONING SYSTEM. WIRING SHALL BE INSTALLED PER THE CURRENT INDIANA NEC CODE.
- 4. CONTRACTOR SHALL PROVIDE AND INSTALL NEW CABINET UNIT HEATER IN THE SAME LOCATION AS THE PREVIOUSLY REMOVED HEATER. TE-IN AND CONNECT NEW HYDRONIC HOT WATER SUPPLY AND RETURN PIPING TO THE EXISTING PIPING WITHIN THE WALL AND MAKE CONNECTIONS TO THE HEATER. PROVIDE AND INSTALL ALL NEW VALVES, COMPONENTS, ACCESSORIES AND NEW TEMPERATURE CONTROL VALVES FOR A COMPLETE AND FUNCTIONING SYSTEM. MECHANICAL CONTRACTOR TO PROVIDE AND INSTALL ALL NECESSARY OFFSETS AND TRANSITIONS IN PIPING AS REQUIRED FOR CONNECTION TO UNIT. MECHANICAL CONTRACTOR SHALL BE RESPONSIBLE TO CUT AND NOTCH EXISTING WALL AS REQUIRED FOR INSTALLATION OF HEATER AND ALL COMPONENTS. CONTRACTOR SHALL PATCH THE EXISTING WALL AS REQUIRED TO MATCH THE SURROUNDING CONDITIONS AND PROVIDE A FULLY SEALED WALL CONDITION. REFER TO UNIT HEATER & CABINET UNIT HEATER 2-WAY VALVE CONTROL PIPING DETAIL FOR ADDITIONAL INFORMATION.
- 5. CONTRACTOR SHALL PROVIDE AND INSTALL NEW FIN TUBE RADIATOR IN THE SAME LOCATION AS THE PREVIOUSLY REMOVED HEATER. TE-IN AND CONNECT NEW HYDRONIC HOT WATER SUPPLY AND RETURN PIPING TO THE EXISTING PIPING WITHIN THE WALL AND MAKE CONNECTIONS TO THE HEATER. PROVIDE AND INSTALL ALL NEW VALVES, COMPONENTS, ACCESSORIES AND NEW TEMPERATURE CONTROL VALVES FOR A COMPLETE AND FUNCTIONING SYSTEM. MECHANICAL CONTRACTOR TO PROVIDE AND INSTALL ALL NECESSARY OFFSETS AND TRANSITIONS IN PIPING AS REQUIRED FOR CONNECTION TO UNIT. CONTRACTOR SHALL FIELD MEASURE AND VERIFY THE EXACT LENGTH OF FIN TUBE AND ENCLOSURE THAT IS REQUIRED TO BE INSTALLED IN THE LOCATION SHOWN. MECHANICAL CONTRACTOR SHALL BE RESPONSIBLE TO CUT AND NOTCH EXISTING WALL AS REQUIRED FOR INSTALLATION OF HEATER AND ALL COMPONENTS. CONTRACTOR SHALL PATCH THE EXISTING WALL AS REQUIRED TO MATCH THE SURROUNDING CONDITIONS AND PROVIDE A FULLY SEALED WALL CONDITION. REFER TO UNIT HEATER & CABINET UNIT HEATER 2-WAY VALVE CONTROL PIPING DETAIL FOR ADDITIONAL INFORMATION.
- 6. CONTRACTOR SHALL PROVIDE AND INSTALL NEW CEILING HUNG CABINET UNIT HEATER IN THE SUSPENDED ACOUSTICAL CEILING GRID AS SHOWN. MODIFY AND TE-IN NEW HYDRONIC HOT WATER SUPPLY AND RETURN PIPING TO THE EXISTING PIPING ABOVE THE CEILING AND MAKE CONNECTIONS TO THE HEATER. PROVIDE AND INSTALL ALL NEW VALVES, COMPONENTS, ACCESSORIES AND NEW TEMPERATURE CONTROL VALVES FOR A COMPLETE AND FUNCTIONING SYSTEM. MECHANICAL CONTRACTOR TO PROVIDE AND INSTALL ALL NECESSARY OFFSETS AND TRANSITIONS IN PIPING AS REQUIRED FOR CONNECTION TO UNIT. REFER TO UNIT HEATER & CABINET UNIT HEATER 2-WAY VALVE CONTROL PIPING DETAIL FOR ADDITIONAL INFORMATION.
- 7. CONTRACTOR SHALL PROVIDE AND INSTALL NEW CEILING MOUNTED DRAINAGE FAN TO BE INSTALLED IN THE SAME LOCATION AS THE PREVIOUSLY REMOVED FAN. TE-IN AND CONNECT EXISTING DRAINAGE DUCTWORK TO THE NEW FAN. PROVIDE AND INSTALL ALL HANGERS/SUPPORTS, WIRING, TRANSITIONS AND FITTINGS WITHIN THE DUCTWORK FOR A COMPLETE AND FUNCTIONING SYSTEM. DRAINAGE FAN IS TO BE INTERLOCKED TO THE EXISTING LIGHT SWITCH IN THE ROOM FOR FAN OPERATION.
- 8. PROVIDE AND INSTALL NEW DDC CONTROLS, INCLUDING ALL NEW ELECTRONIC DAMPER ACTUATORS, ELECTRIC HOT WATER/CHILLED WATER CONTROL VALVES, NEW FREEZE STAT, SENSORS, CONTROL WIRING, RELAYS, AND ACCESSORIES REQUIRED FOR A COMPLETE AND FUNCTIONING SYSTEM. CONTRACTOR SHALL BE RESPONSIBLE TO PROVIDE AND INSTALL ALL ELECTRICAL POWER, COMPONENTS/WIRING AND PROGRAMMING AS REQUIRED TO CONNECT THE SYSTEM FOR A FULLY FUNCTIONING SYSTEM. WIRING SHALL BE INSTALLED PER THE CURRENT INDIANA NEC CODE.
- 9. CONTRACTOR SHALL PROVIDE AND INSTALL NEW CEILING HUNG CABINET UNIT HEATER IN THE SUSPENDED ACOUSTICAL CEILING GRID IN LOCATION SHOWN. CONTRACTOR SHALL VERIFY FINAL INSTALLATION LOCATION OF THE NEW HEATER WITH THE EXISTING LIGHTING FIXTURES THAT ARE TO REMAIN. HEATER IS TO BE INSTALLED IN A LOCATION THAT DOES NOT REQUIRE THE LIGHTS TO BE RELOCATED. MODIFY AND TE-IN NEW HYDRONIC HOT WATER SUPPLY AND RETURN PIPING TO THE EXISTING PIPING ABOVE THE CEILING AND MAKE CONNECTIONS TO THE HEATER. ALL EXISTING PIPING WITHIN THE WALL THAT WAS PREVIOUSLY CONNECTED TO THE REMOVED FIN TUBE IS TO BE CAPPED AND ASSHODD IN PLACE. PROVIDE AND INSTALL ALL NEW VALVES, COMPONENTS, ACCESSORIES AND NEW TEMPERATURE CONTROL VALVES FOR A COMPLETE AND FUNCTIONING SYSTEM. MECHANICAL CONTRACTOR TO PROVIDE AND INSTALL ALL NECESSARY OFFSETS AND TRANSITIONS IN PIPING AS REQUIRED FOR CONNECTION TO UNIT. MECHANICAL CONTRACTOR SHALL BE RESPONSIBLE TO CUT AND NOTCH THE EXISTING WALL AS REQUIRED FOR REMOVAL OF THE FIN TUBE HEATER AND ALL COMPONENTS. CONTRACTOR SHALL PATCH THE EXISTING WALL AS WITH FULL CMU BLOCK AS REQUIRED TO MATCH THE SURROUNDING CONDITIONS AND PROVIDE A FULLY SEALED WALL CONDITION. REFER TO UNIT HEATER & CABINET UNIT HEATER 2-WAY VALVE CONTROL PIPING DETAIL FOR ADDITIONAL INFORMATION.

IT IS THE INTENT OF THIS PROJECT THAT THE MECHANICAL CONTRACTOR SHALL REMOVE THE EXISTING CEILING GRID AND CEILING TILES AS REQUIRED FOR THE REMOVAL AND REINSTALLATION OF NEW WORK. ONCE THE WORK IS COMPLETE, THE CONTRACTOR SHALL REINSTALL THE PREVIOUSLY REMOVED CEILING GRID AND TILES TO MATCH THE SURROUNDING AREAS. IF ANY OF THE GRID OR TILES IS DAMAGED DURING CONSTRUCTION, IT IS THE RESPONSIBILITY OF THE MECHANICAL CONTRACTOR TO PROVIDE AND INSTALL NEW GRID/TILES. REFER TO ARCHITECTURAL PLANS FOR ADDITIONAL INFORMATION AND REQUIREMENTS.


IT IS THE INTENT OF THIS PROJECT THAT ALL NEW HVAC EQUIPMENT SHALL BE PROVIDED WITH NEW DDC CONTROLS COMPLETE, INCLUDING ALL NEW ELECTRONIC DAMPER ACTUATORS, ELECTRIC HOT WATER/CHILLED WATER CONTROL VALVES, NEW FREEZE STAT, SENSORS, CONTROL WIRING, RELAYS, AND ACCESSORIES REQUIRED FOR A COMPLETE AND FUNCTIONING SYSTEM. CONTRACTOR SHALL BE RESPONSIBLE TO PROVIDE AND INSTALL ALL ELECTRICAL POWER, COMPONENTS/WIRING AND PROGRAMMING AS REQUIRED TO CONNECT THE SYSTEM FOR A FULLY FUNCTIONING SYSTEM. WIRING SHALL BE INSTALLED PER THE CURRENT INDIANA NEC CODE.

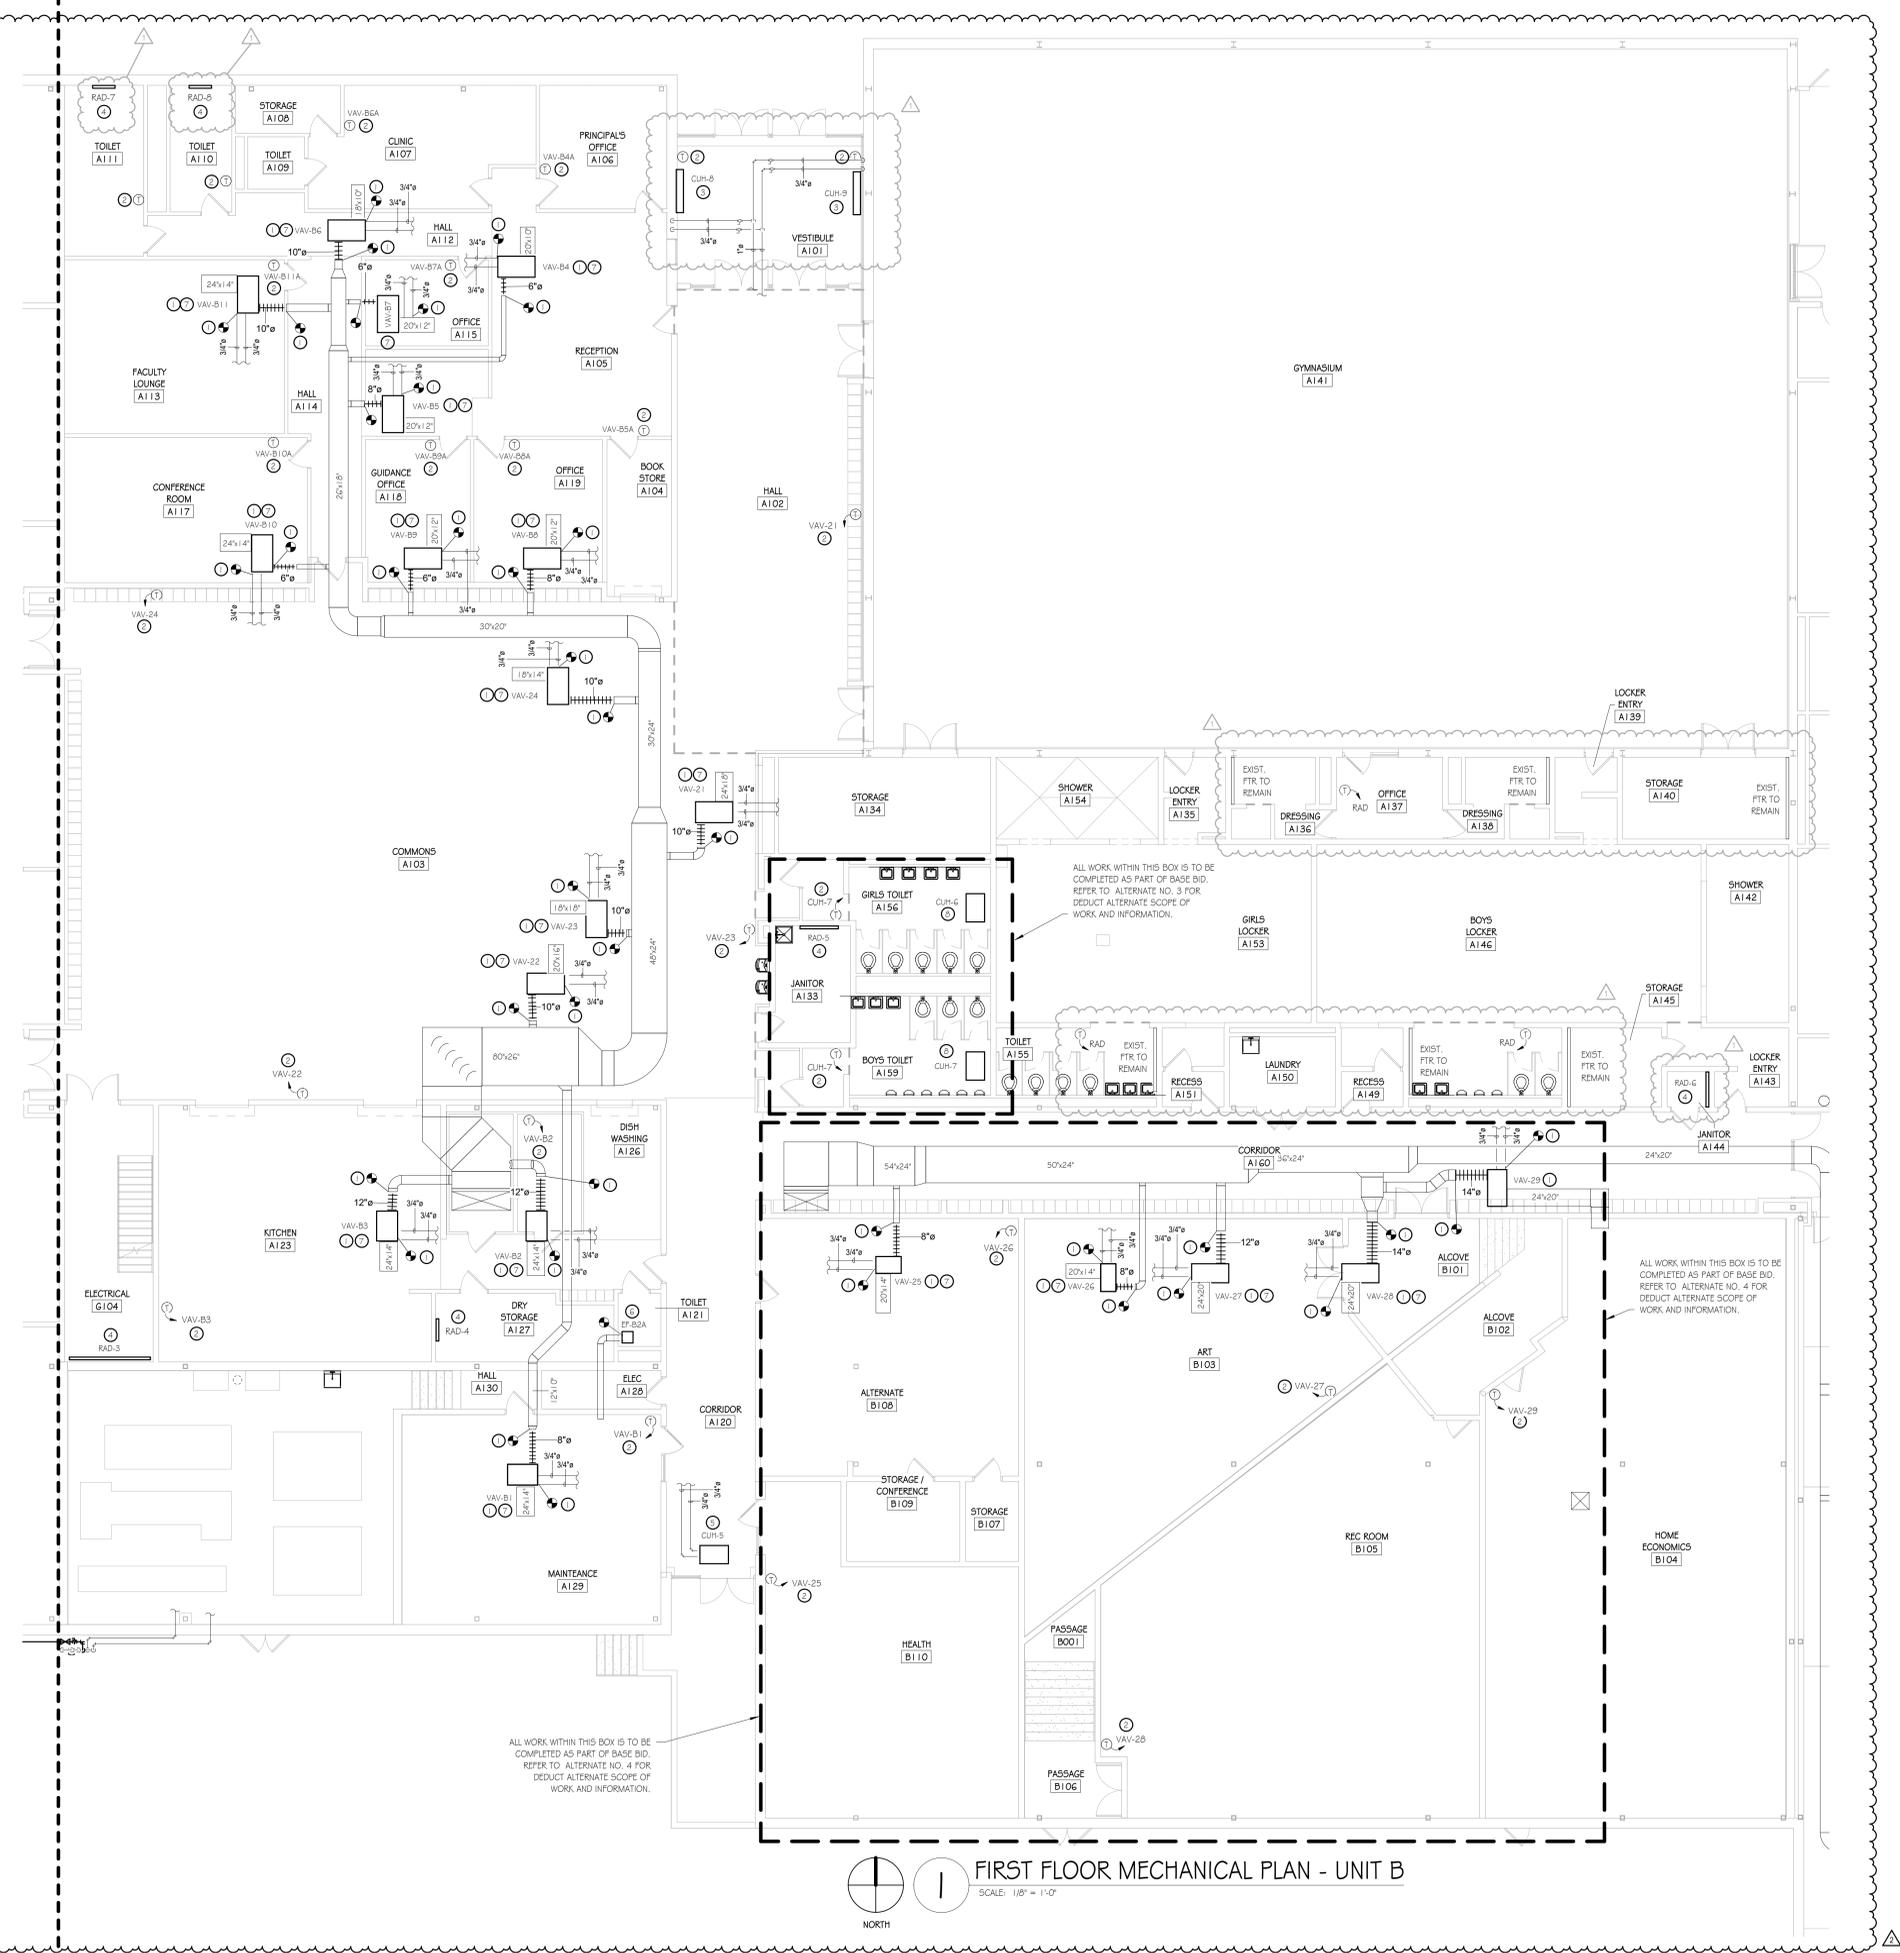

FIRST FLOOR MECHANICAL PLAN - UNIT B
SCALE: 1/8" = 1'-0"
NORTH

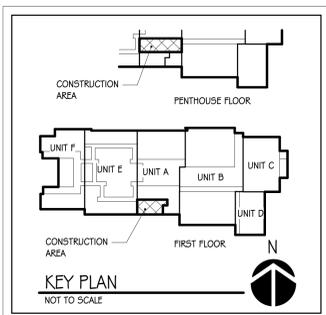

one and one half inches = one foot
one inch = one foot
three quarters inch = one foot
one half inch = one foot
one eighth inch = one foot
one quarter inch = one foot
one eighth inch = one foot

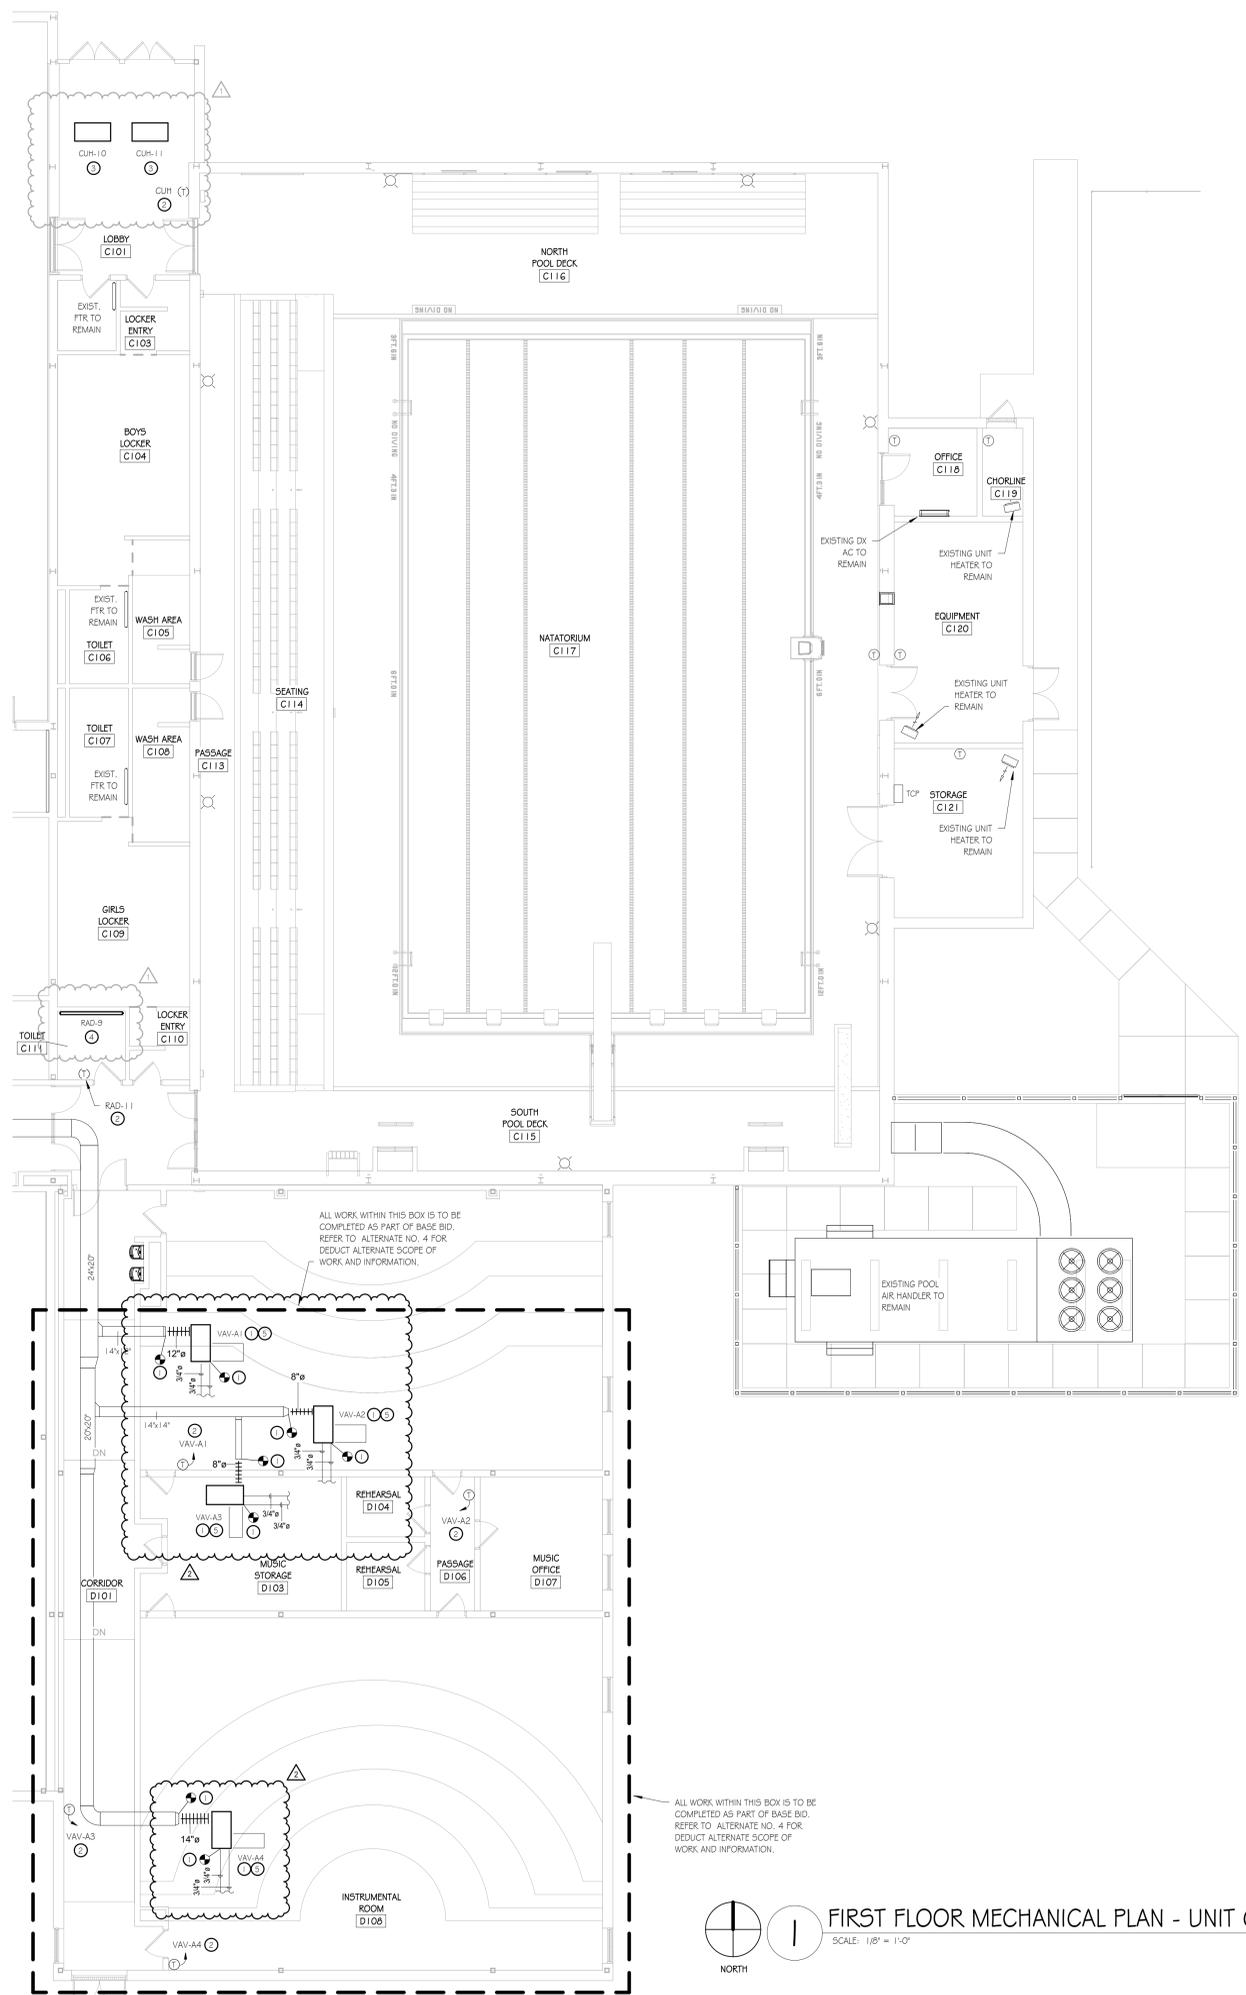

one and one half inches = one foot
 one inch = one foot
 three quarters inch = one foot
 one half inch = one foot
 three eighths inch = one foot
 one quarter inch = one foot
 one eighth inch = one foot
 16

MECHANICAL PLAN NOTES

- 1. ALL SCOPE OF WORK WITHIN SERIES OF DRAWINGS, ARE THE RESPONSIBILITY OF THE MECHANICAL CONTRACTOR. MECHANICAL CONTRACTOR SHALL COORDINATE ALL WORK WITHIN THIS SCOPE OF WORK WITH ALL OTHER TRADES AND GENERAL CONTRACTOR/CONSTRUCTION MANAGER.
- 2. CONTRACTOR SHALL PROVIDE AND INSTALL NEW FAN POWERED VAV BOX IN THE SAME LOCATION AS THE PREVIOUSLY REMOVED BOX. PROVIDE AND INSTALL A PERMANENTLY AFFIXED EQUIPMENT LABEL TO THE CEILING GRID TO IDENTIFY THE LOCATION OF THE UNIT. COORDINATE INSTALLATION LOCATION OF THE LABEL WITH THE OWNER PRIOR TO INSTALLATION. CONTRACTOR SHALL PROVIDE AND INSTALL ALL REQUIRED COMPONENTS, WIRING, DUCTWORK, CONTROLS, AND ACCESSORIES REQUIRED FOR A COMPLETE AND FUNCTIONING SYSTEM. TIE-IN AND CONNECT TO EXISTING HOT WATER SUPPLY AND HOT WATER RETURN PIPING. MECHANICAL CONTRACTOR SHALL MODIFY AND EXTEND THE EXISTING SHEETMETAL DUCTWORK AS REQUIRED TO INSTALL THE NEW VAV BOX. PROVIDE AN ADDITIONAL 5'-0" LINEAR FOOT OF DUCTWORK AND RE-CONNECT TO THE EXISTING DUCTWORK AND EXTEND THE DUCTWORK AS REQUIRED FOR THE INSTALLATION OF THE VAV IN THE LOCATION AS SHOWN. PROVIDE AND INSTALL ALL NECESSARY OFFSETS AND TRANSITIONS IN DUCTWORK AS REQUIRED. ROUTE HYDRONIC PIPING TO UNIT PER 2-WAY OR 3-WAY PIPING DETAIL ON SHEET MS-1. REFER TO SERIES FAN POWERED VARIABLE AIR VOLUME BOX SCHEDULE FOR VALVE REQUIREMENT.
- 3. PROVIDE AND INSTALL NEW DDC TEMPERATURE SENSOR/THERMOSTAT TO BE INSTALLED WITHIN THE SAME LOCATION AS THE PREVIOUSLY REMOVED THERMOSTAT. THE NEW SENSOR SHALL BE INSTALLED WITHIN THE EXISTING WALL BOX AND THE NEW CONTROL WIRING SHALL BE ROUTED DOWN THE WALL WITHIN THE EXISTING CONDUIT FOR CONNECTION TO THE NEW SENSOR. TEMPERATURE CONTROLS CONTRACTOR SHALL PROVIDE AND INSTALL ALL CONTROL WIRING, RELAYS, AND ACCESSORIES AS REQUIRED FOR A COMPLETE AND FUNCTIONING SYSTEM. CONTRACTOR SHALL BE RESPONSIBLE TO PROVIDE AND INSTALL ALL ELECTRICAL COMPONENTS/WIRING AS REQUIRED TO CONNECT THE SYSTEM FOR A FULLY FUNCTIONING SYSTEM. WIRING SHALL BE INSTALLED PER THE CURRENT INDIANA NEC CODE.
- 4. CONTRACTOR SHALL PROVIDE AND INSTALL NEW CEILING HUNG CABINET UNIT HEATER IN THE SUSPENDED ACoustICAL CEILING GRID AS SHOWN. MODIFY AND TIE-IN NEW HYDRONIC HOT WATER SUPPLY AND RETURN PIPING TO THE EXISTING PIPING ABOVE THE CEILING AND MAKE CONNECTIONS TO THE HEATER. PROVIDE AND INSTALL ALL NEW VALVES, COMPONENTS, ACCESSORIES AND NEW TEMPERATURE CONTROL VALVES FOR A COMPLETE AND FUNCTIONING SYSTEM. MECHANICAL CONTRACTOR TO PROVIDE AND INSTALL ALL NECESSARY OFFSETS AND TRANSITIONS IN PIPING AS REQUIRED FOR CONNECTION TO UNIT. REFER TO UNIT HEATER & CABINET UNIT HEATER 2-WAY VALVE CONTROL PIPING DETAIL FOR ADDITIONAL INFORMATION.
- 5. CONTRACTOR SHALL PROVIDE AND INSTALL NEW FIN TUBE RADIATOR IN THE SAME LOCATION AS THE PREVIOUSLY REMOVED HEATER. TIE-IN AND CONNECT NEW HYDRONIC HOT WATER SUPPLY AND RETURN PIPING TO THE EXISTING PIPING WITHIN THE WALL AND MAKE CONNECTIONS TO THE HEATER. PROVIDE AND INSTALL ALL NEW VALVES, COMPONENTS, ACCESSORIES AND NEW TEMPERATURE CONTROL VALVES FOR A COMPLETE AND FUNCTIONING SYSTEM. MECHANICAL CONTRACTOR TO PROVIDE AND INSTALL ALL NECESSARY OFFSETS AND TRANSITIONS IN PIPING AS REQUIRED FOR CONNECTION TO UNIT. CONTRACTOR SHALL FIELD MEASURE AND VERIFY THE EXACT LENGTH OF FIN TUBE AND ENCLOSURE THAT IS REQUIRED TO BE INSTALLED IN THE LOCATION SHOWN. MECHANICAL CONTRACTOR SHALL BE RESPONSIBLE TO CUT AND NOTCH EXISTING WALL AS REQUIRED FOR INSTALLATION OF HEATER AND ALL COMPONENTS. CONTRACTOR SHALL PATCH THE EXISTING WALL AS REQUIRED TO MATCH THE SURROUNDING CONDITIONS AND PROVIDE A FULLY SEALED WALL CONDITION. REFER TO UNIT HEATER & CABINET UNIT HEATER 2-WAY VALVE CONTROL PIPING DETAIL FOR ADDITIONAL INFORMATION.
- 6. PROVIDE AND INSTALL NEW DDC CONTROLS, INCLUDING ALL NEW ELECTRONIC DAMPER ACTUATORS, ELECTRONIC HOT WATER/CHILLED WATER CONTROL VALVES, NEW FREEZE STAT, SENSORS, CONTROL WIRING, RELAYS, AND ACCESSORIES TO THE NEW AIR HANDLING UNIT THAT AS REQUIRED FOR A COMPLETE AND FUNCTIONING SYSTEM. CONTRACTOR SHALL BE RESPONSIBLE TO PROVIDE AND INSTALL ALL ELECTRICAL POWER, COMPONENTS/WIRING AND PROGRAMMING AS REQUIRED TO CONNECT THE SYSTEM FOR A FULLY FUNCTIONING SYSTEM. WIRING SHALL BE INSTALLED PER THE CURRENT INDIANA NEC CODE.

IT IS THE INTENT OF THIS PROJECT THAT THE MECHANICAL CONTRACTOR SHALL REMOVE THE EXISTING CEILING GRID AND CEILING TILES AS REQUIRED FOR THE REMOVAL AND REINSTALLATION OF NEW WORK. ONCE ALL THE WORK IS COMPLETE, THE CONTRACTOR SHALL REINSTALL THE PREVIOUSLY REMOVED CEILING GRID AND TILES TO MATCH THE SURROUNDING AREAS. IF ANY OF THE GRID OR TILES IS DAMAGED DURING CONSTRUCTION, IT IS THE RESPONSIBILITY OF THE MECHANICAL CONTRACTOR TO PROVIDE AND INSTALL NEW GRID/TILES. REFER TO ARCHITECTURAL PLANS FOR ADDITIONAL INFORMATION AND REQUIREMENTS.

IT IS THE INTENT OF THIS PROJECT THAT ALL NEW HVAC EQUIPMENT SHALL BE PROVIDED WITH NEW DDC CONTROLS COMPLETE, INCLUDING ALL NEW ELECTRONIC DAMPER ACTUATORS, ELECTRONIC HOT WATER/CHILLED WATER CONTROL VALVES, NEW FREEZE STAT, SENSORS, CONTROL WIRING, RELAYS, AND ACCESSORIES REQUIRED FOR A COMPLETE AND FUNCTIONING SYSTEM. CONTRACTOR SHALL BE RESPONSIBLE TO PROVIDE AND INSTALL ALL ELECTRICAL POWER, COMPONENTS/WIRING AND PROGRAMMING AS REQUIRED TO CONNECT THE SYSTEM FOR A FULLY FUNCTIONING SYSTEM. WIRING SHALL BE INSTALLED PER THE CURRENT INDIANA NEC CODE.



6435 West Jefferson Blvd. #144
Fort Wayne, Indiana 46804
PH: 260-450-7299
www.viridian-design.net

CERTIFICATION



All Concepts, ideas, design elements, plans, and details as shown on this document are the sole property of Viridian Architectural Design, Inc. and shall not be used for any purpose without prior expressed written consent. The Owner shall be permitted to retain copies for information and reference.




FORT WAYNE: 6534 Constitution Drive Fort Wayne, IN 46804 (260) 436-9213 (260) 432-5481 fax sco@sc-engineering.com

This is an original design, created by SCO ENGINEERING, LLC. The concepts, ideas, plans and details are the sole property of SCO ENGINEERING, LLC. None of the concepts, ideas, plans or details shall be used by or disclosed to any person, firm or corporation for any purpose without the prior written permission of SCO ENGINEERING, LLC. Written dimensions on these drawings shall have precedence over scale dimensions. Contractors shall verify and be responsible for all dimensions and conditions on the job and SCO ENGINEERING, LLC must be notified of any variation from the dimensions and conditions shown on these drawings. Shop drawings shall be submitted to SCO ENGINEERING, LLC for approval before fabrication. Copyright 2025 ©

RCSC Middle School
HVAC Replacement
690 Zebra Lane
Rochester, IN

REVISION	DATE	DESCRIPTION
1	01-12-26	Addendum 02
2	01-12-26	Addendum 03

DATE	PROJECT
12/22/25	20250008
TITLE	
FIRST FLOOR MECHANICAL PLAN - UNIT C	
SHEET	
MI.IC	

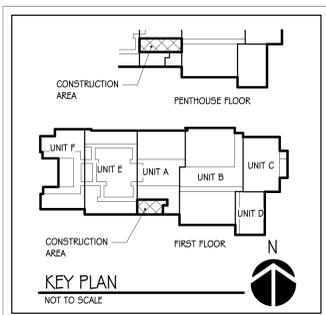

FIRST FLOOR MECHANICAL PLAN - UNIT C
 SCALE: 1/8" = 1'-0"
 NORTH

CERTIFICATION



All Concepts, Ideas, Design Elements, Plans, and Details as shown on this document are the sole property of Viridian Architectural Design, Inc. and shall not be used for any purpose without prior expressed written consent. The Owner shall be permitted to retain copies for information and reference.



SOLUTIONS PROVIDED • PROBLEMS SOLVED
FORT WAYNE, IN 46804
6534 Conantville Drive
Fort Wayne, IN 46804
(260) 436-9213
(260) 432-5481 fax
scow@seo-llc.com



This is an original design, created by SCO ENGINEERING, LLC. The concepts, ideas, plans and details are the sole property of SCO ENGINEERING, LLC. None of the concepts, ideas, plans or details shall be used by or disclosed to any person, firm or corporation for any purpose without the prior written permission of SCO ENGINEERING, LLC. Written dimensions on these drawings shall have precedence over scale dimensions. Contractors shall verify and be responsible for all dimensions and conditions on the job and SCO ENGINEERING, LLC must be notified of any variation from the dimensions and conditions shown on these drawings. Shop drawings shall be submitted to SCO ENGINEERING, LLC for approval before fabrication.
Copyright 2025 ©

MECHANICAL PLAN NOTES

- 1. ALL SCOPE OF WORK WITHIN SERIES OF DRAWINGS, ARE THE RESPONSIBILITY OF THE MECHANICAL CONTRACTOR. MECHANICAL CONTRACTOR SHALL COORDINATE ALL WORK WITH ALL OTHER TRADES AND GENERAL CONTRACTOR/CONSTRUCTION MANAGER.
- 2. PROVIDE AND INSTALL NEW AIR HANDLING UNIT THAT IS TO BE INSTALLED IN THE SAME LOCATION AS THE PREVIOUSLY REMOVED UNIT. AIR HANDLER IS TO BE SET ON EXISTING STEEL STAND, CONTRACTOR SHALL MODIFY AND EXTEND THE EXISTING STRUCTURE AS REQUIRED FOR THE INSTALLATION OF THE UNIT. CONTRACTOR SHALL RE-CONNECT ALL SUPPLY AND RETURN AIR DUCTWORK, HYDRONIC CHILLED WATER AND HOT WATER HEAT PIPING, CONDENSATE DRAIN PIPING AND ALL ASSOCIATED ACCESSORIES FOR A COMPLETE AND FUNCTIONING SYSTEM. TRANSITION SUPPLY AND RETURN DUCTS AS REQUIRED DOWN TO NEW AIR HANDLER. MAINTAIN MANUFACTURER REQUIRED CLEARANCE FOR SERVICE ACCESS AND PROPER PERFORMANCE. COORDINATE EXACT LOCATION WITH ALL TRADES.
- 3. TE-IN AND CONNECT NEW SUPPLY AIR, RETURN AIR, AND OUTSIDE AIR DUCTWORK THAT IS ROUTED DOWN THROUGH THE MEZZANINE FLOOR AS SHOWN. MECHANICAL CONTRACTOR SHALL PROVIDE AND INSTALL ALL TRANSITIONS AND OFFSETS IN THE DUCTWORK AS REQUIRED FOR CONNECTION TO THE AIR HANDLING UNIT.
- 4. TEMPERATURE CONTROLS CONTRACTOR SHALL PROVIDE AND INSTALL NEW VARIABLE-SPEED DRIVES FOR AIR HANDLING UNITS COMPLETE FOR A FULLY FUNCTIONING SYSTEM. COORDINATE INSTALLATION LOCATION WITH MANUFACTURER'S CLEARANCES AND PROVIDE AND INSTALL VFD ON METAL UNI-STRUT STAND SEPARATE FROM UNIT.
- 5. AFTER ALL THE NEW EQUIPMENT HAS BEEN BROUGHT INTO THE MEZZANINE THROUGH THE EXISTING LOUVER OPENING, THE CONTRACTOR SHALL CAREFULLY RE-INSTALL THE PREVIOUSLY REMOVED LOUVER. PROVIDE AND INSTALL BACKER ROOF AND NON-SHRINKING CAULK AROUND THE PERIMETER OF THE LOUVER FOR A WEATHER TIGHT INSTALLATION. CAULKING SHALL BE INSTALLED TO PREVENT THE INFILTRATION OF OUTDOOR AIR INTO THE BUILDING ENVELOPE. ARCHITECT TO SELECT COLOR OF CAULKING.
- 6. PROVIDE AND INSTALL NEW CEILING HUNG UNIT HEATER TO BE INSTALLED IN THE SAME LOCATION AS THE PREVIOUSLY REMOVED UNIT. TE-IN AND CONNECT TO EXISTING HOT WATER SUPPLY AND HOT WATER RETURN PIPING. ROUTE HYDRONIC PIPING TO UNIT PER 2-WAY OR 3-WAY PIPING DETAIL ON SHEET MS.1.
- 7. PROVIDE AND INSTALL NEW DDC TEMPERATURE SENSOR/THERMOSTAT, MOTOR STARTER, DISCONNECT SWITCH, AND FAN SPEED SELECTOR TO BE INSTALLED WITHIN THE SAME LOCATION AS THE PREVIOUSLY REMOVED. THE NEW SENSOR SHALL BE INSTALLED WITHIN THE EXISTING WALL BOX AND THE NEW CONTROL WIRING SHALL BE ROUTED DOWN THE WALL WITHIN THE EXISTING CONDUIT FOR CONNECTION TO THE NEW SENSOR. TEMPERATURE CONTROLS CONTRACTOR SHALL PROVIDE AND INSTALL ALL CONTROL WIRING, RELAYS, AND ACCESSORIES AS REQUIRED FOR A COMPLETE AND FUNCTIONING SYSTEM. CONTRACTOR SHALL BE RESPONSIBLE TO PROVIDE AND INSTALL ALL ELECTRICAL COMPONENTS/WIRING AS REQUIRED TO CONNECT THE SYSTEM FOR A FULLY FUNCTIONING SYSTEM. WIRING SHALL BE INSTALLED PER THE CURRENT INDIANA NEC CODE.
- 8. TE-IN AND CONNECT NEW HYDRONIC CHILLED WATER SUPPLY, CHILLED WATER RETURN, HOT WATER SUPPLY, AND HOT WATER RETURN PIPING TO THE EXISTING PIPING AND ROUTE FOR CONNECTION TO THE NEW AIR HANDLING UNITS. PROVIDE AND INSTALL ALL NEW FLOW CONTROL, CONTROL VALVES, CIRCULATING PUMP, AND ALL REQUIRED ACCESSORIES FOR A COMPLETE AND FUNCTIONING SYSTEM. CONTRACTOR TO PROVIDE AND INSTALL ALL NECESSARY OFFSETS AND TRANSITIONS IN THE PIPING AS REQUIRED FOR ROUTING AND INSTALLATION. FIELD VERIFY THE EXACT ROUTE AND LOCATION OF PIPING WITH EXISTING STRUCTURE AND EQUIPMENT. REFER TO AIR HANDLER 2-WAY MODULATING VALVE COOLING + HEATING COIL + CIRCULATION PUMP DETAIL FOR ADDITIONAL PIPING REQUIREMENTS AND INFORMATION.
- 9. TE-IN AND CONNECT NEW HYDRONIC HOT WATER SUPPLY, AND HOT WATER RETURN PIPING TO THE EXISTING PIPING AND ROUTE FOR CONNECTION TO THE NEW AIR HANDLING UNITS. PROVIDE AND INSTALL ALL NEW FLOW CONTROL, CONTROL VALVES, AND ALL REQUIRED ACCESSORIES FOR A COMPLETE AND FUNCTIONING SYSTEM. CONTRACTOR TO PROVIDE AND INSTALL ALL NECESSARY OFFSETS AND TRANSITIONS IN THE PIPING AS REQUIRED FOR ROUTING AND INSTALLATION. FIELD VERIFY THE EXACT ROUTE AND LOCATION OF PIPING WITH EXISTING STRUCTURE AND EQUIPMENT. REFER TO AIR HANDLER 2-WAY MODULATING VALVE COOLING + HEATING COIL DETAIL FOR ADDITIONAL PIPING REQUIREMENTS AND INFORMATION.
- 10. PROVIDE AND INSTALL NEW DDC CONTROLS, INCLUDING ALL NEW ELECTRONIC DAMPER ACTUATORS, ELECTRONIC HOT WATER/CHILLED WATER CONTROL VALVES, NEW FREEZE STAT, SENSORS, CONTROL WIRING, RELAYS, AND ACCESSORIES TO THE NEW AIR HANDLING UNIT THAT AS REQUIRED FOR A COMPLETE AND FUNCTIONING SYSTEM. CONTRACTOR SHALL BE RESPONSIBLE TO PROVIDE AND INSTALL ALL ELECTRICAL POWER, COMPONENTS/WIRING AND PROGRAMMING AS REQUIRED TO CONNECT THE SYSTEM FOR A FULLY FUNCTIONING SYSTEM. WIRING SHALL BE INSTALLED PER THE CURRENT INDIANA NEC CODE.

IT IS THE INTENT OF THIS PROJECT THAT ALL NEW HVAC EQUIPMENT SHALL BE PROVIDED WITH NEW DDC CONTROLS COMPLETE, INCLUDING ALL NEW ELECTRONIC DAMPER ACTUATORS, ELECTRONIC HOT WATER/CHILLED WATER CONTROL VALVES, NEW FREEZE STAT, SENSORS, CONTROL WIRING, RELAYS, AND ACCESSORIES REQUIRED FOR A COMPLETE AND FUNCTIONING SYSTEM. CONTRACTOR SHALL BE RESPONSIBLE TO PROVIDE AND INSTALL ALL ELECTRICAL POWER, COMPONENTS/WIRING AND PROGRAMMING AS REQUIRED TO CONNECT THE SYSTEM FOR A FULLY FUNCTIONING SYSTEM. WIRING SHALL BE INSTALLED PER THE CURRENT INDIANA NEC CODE.

one and one half inches = one foot
one inch = one foot
three quarters inch = one foot
one half inch = one foot
three eighths inch = one foot
one quarter inch = one foot
one eighth inch = one foot

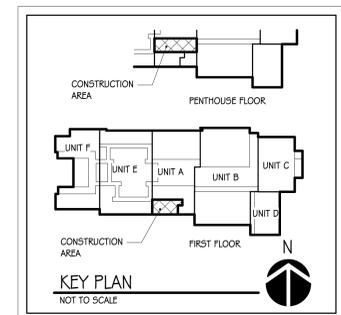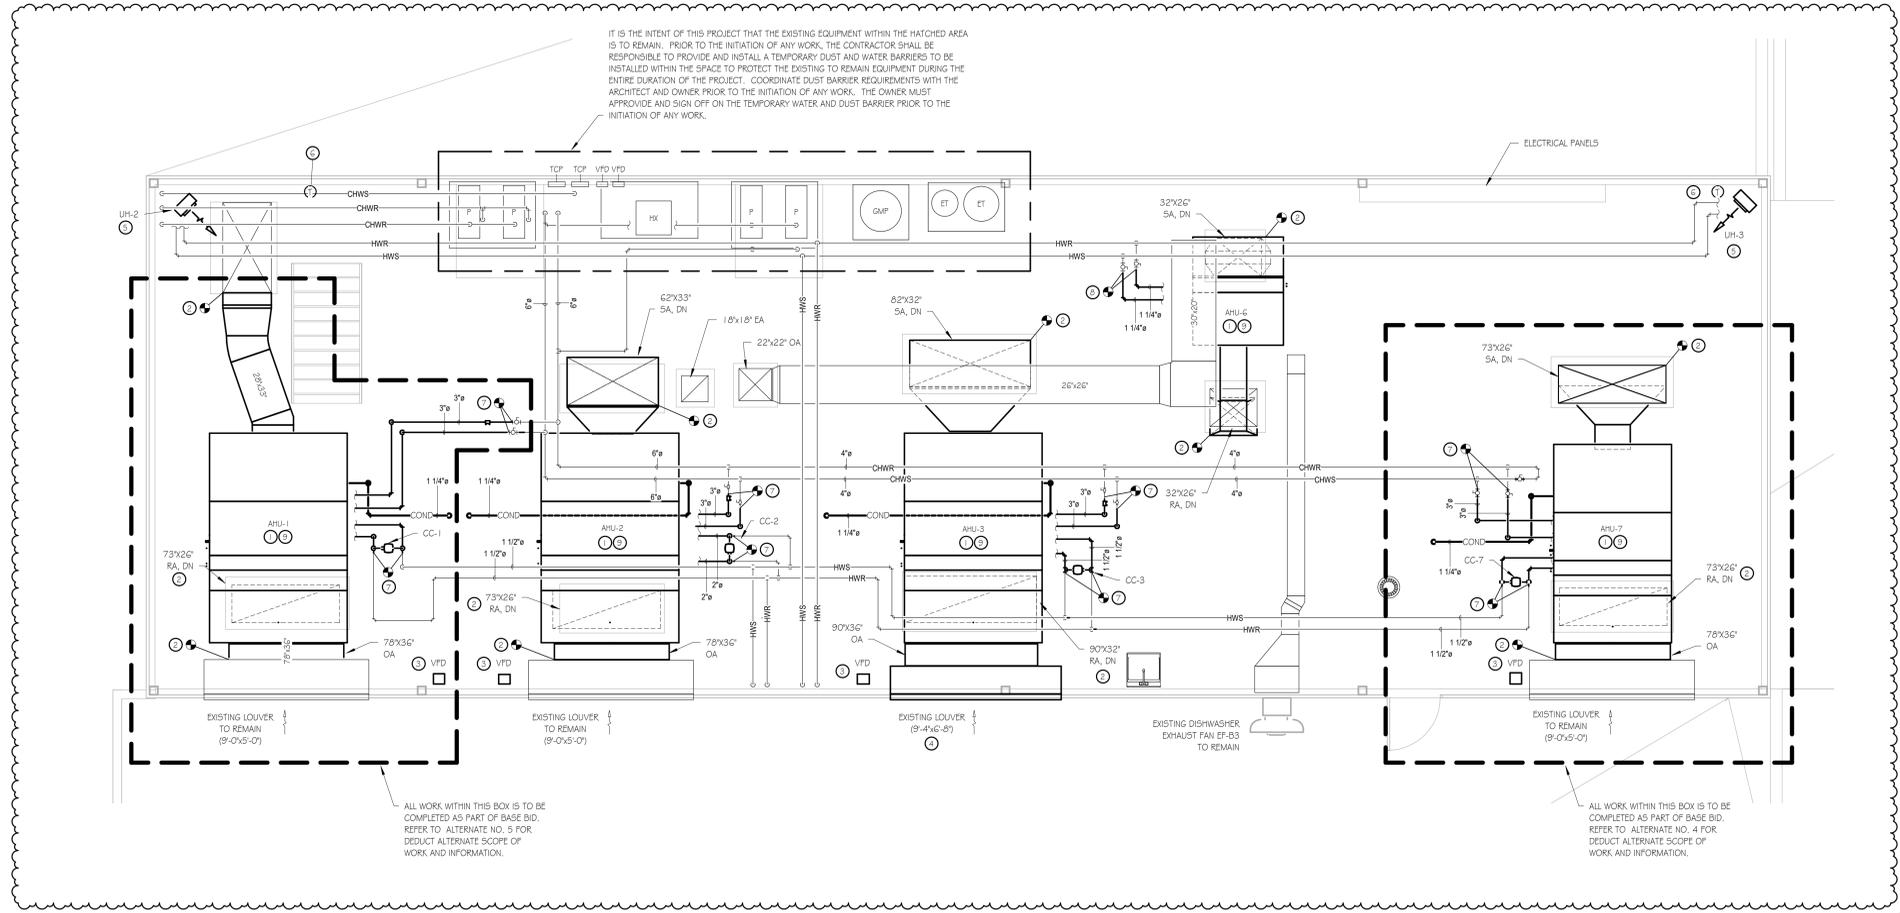

PENTHOUSE MECHANICAL PLAN
SCALE: 1/4" = 1'-0"
NORTH

REVISION	DATE	DESCRIPTION
1	01-12-26	Addendum 02

DATE	PROJECT
12/22/25	20250008
TITLE	
PENTHOUSE MECHANICAL PLAN	
SHEET	

MI.2